

# STATE WELL REPORT

## Part 1

### Driller's Log

Mississippi Department of Environmental Quality  
Office of Land and Water Resources  
P.O. Box 2309  
Jackson, MS 39225-2309  
(601)961-5210  
(601)360-0535 (fax)

#### For Office Use Only:

Well #: K145  
Aquifer: \_\_\_\_\_  
E-Log #: \_\_\_\_\_

County: Bolivar  
Permit #: MS-GW-49039  
Driller: Tammy Procock  
Date drilling completed: 8-23-15

*State Law requires that this report be prepared by the license holder responsible for the work and filed with the Department at the above address within 30 days of completion of drilling of the well or borehole.*

Well Owner Information <small>(Landowner if borehole is not for a water well)</small>	Well or Borehole Location
Owner Name: <u>David Fisher</u>	Latitude: <u>90° 52' 13"</u> Longitude: <u>33° 46' 10"</u>
Mailing Address: <u>7700 North Kendall Dr</u>	Method of Lat/Long (check one): Conventional Survey _____, USGS quad _____, Hand-held GPS <input checked="" type="checkbox"/> , Survey-grade GPS _____
<u>Suite 405</u>	<u>SE</u> ¼ <u>NE</u> ¼, Sec <u>12</u> T <u>22N</u> R <u>32W</u>
<u>Miami</u> FL <u>33156</u>	<u>1/2</u> Miles <u>South</u> of <u>Pace</u>
City State Zip Code	(Distance) (Direction) (Nearest Town)
Telephone No. <u>(662) 299-8064</u>	

Well / Borehole Data
Date drilling started: <u>8-23-15</u> Date drilling completed: <u>8-23-15</u> Hole depth: <u>115'</u> Hole diameter: <u>24"</u>
Location of the source of any surface water used for drilling: <u>nearby ditch</u>
Method of dosing and volume of Chlorine used in drilling and development: <u>when filling tank</u>
Logs run (circle all applicable): <input checked="" type="checkbox"/> No log run <input type="checkbox"/> Electric <input type="checkbox"/> Gamma Ray <input type="checkbox"/> Density <input type="checkbox"/> Sonic <input type="checkbox"/> Neutron Other: _____
Name of organization running log(s): _____
Purpose of borehole (circle one): <input checked="" type="checkbox"/> Water Well <input type="checkbox"/> Geotechnical/Geological Investigation <input type="checkbox"/> Ground Source Heat Pump <input type="checkbox"/> Seismic Survey <input type="checkbox"/> Other (describe) _____
<i>If drilling is not related to water well construction, skip the remainder of this block</i>
Purpose of Well (circle all applicable): Home <input type="checkbox"/> Industrial <input type="checkbox"/> Public Supply <input type="checkbox"/> <input checked="" type="checkbox"/> Irrigation <input type="checkbox"/> Fish Culture
Other (describe): _____
If a flowing well, method of flow regulation: Valve _____ Other (describe) <u>OCT 08 2015</u>
Static Water Level: <u>9.38</u> feet [above or <input checked="" type="checkbox"/> below] land surface Date measured: _____ <small>(circle one)</small>
Method of measurement (circle one): <input checked="" type="checkbox"/> Steel tape <input type="checkbox"/> Electric tape <input type="checkbox"/> Air line Other (describe): _____
Well depth: <u>115'</u> Well grouted to a depth of: <u>10</u> feet Type of grout (circle one): Neat Cement <input checked="" type="checkbox"/> Bentonite Mix
Casing length: <u>75</u> feet Casing diameter: <u>16"</u> inches Type of casing: <u>PVC</u>
Screen length: <u>40</u> feet Screen diameter: <u>16</u> inches Type of screen: <u>PVC</u>
Screen slot size: <u>2-50</u> inches Setting depth: From <u>75</u> feet to <u>115</u> feet
Type of completion (circle all applicable): <input checked="" type="checkbox"/> Gravel packed <input type="checkbox"/> Underreamed <input type="checkbox"/> Open hole <input type="checkbox"/> Natural Development
Other (describe): _____
Top of lap pipe or reduction in casing: _____ feet

*If telescoped or more than one screen, describe on next page*

Reploring GW - 08080



# STATE WELL REPORT

## Part 2

**Pump Installer's Completion Report**  
 Mississippi Department of Environmental Quality  
 Office of Land and Water Resources  
 P.O. Box 2309  
 Jackson, MS 39225-2309  
 (601)961-5210  
 (601) 360-0535 (fax)

County: Bolivar  
 Permit #: MS-GW-49039  
 Driller: \_\_\_\_\_  
 Date completed: 8-24-15  
Copy information from block on Part 1

**For Office Use Only:**

Well #: K145  
 Aquifer: \_\_\_\_\_

*This part of the report must be completed by a licensed water well contractor or a licensed pump installer. A copy of Part 1 of the report must be attached and both parts filed with the Department at the above address within 30 days of well completion.*

Well Owner Information	Well Location
Owner Name: <u>David Fisher</u>	Latitude: <u>90° 52' 13</u> Longitude: <u>33° 46' 10</u>
Mailing Address: <u>7700 North Kendall Dr</u> <u>Suite 405</u>	Method of Lat/Long (check one): Conventional Survey _____, USGS quad _____, Hand-held GPS <input checked="" type="checkbox"/> , Survey-grade GPS _____
<u>Miami</u> <u>FL</u> <u>33156</u> City State Zip Code	<u>SE</u> $\frac{1}{4}$ <u>NE</u> $\frac{1}{4}$ , Sec <u>12</u> T <u>22N</u> R <u>3W</u>
Telephone No. (____) _____	<u>1 1/2</u> Miles <u>South</u> of <u>Pace</u> (Distance) (Direction) (Nearest Town)

**Pump Type (circle one)**

Submersible  Turbine  Air Lift  Centrifugal  Flowing Well  Jet  Piston  Rotary  Other (describe): \_\_\_\_\_

Date Pump Installed: 8-24-15 Rated Pump Capacity: 1400 Gallons Per Minute

Is This Pump (circle one): New  Repaired  Replacement

**Power Type (circle one)**

Electric  Diesel  Gasoline  Natural Gas  Tractor PTO  Windmill  Other (describe): \_\_\_\_\_

Horse Power Rating of Motor: 30 Setting Depth: 80 feet Number of Stages: 1-8"

**Pump Test Data for Non Flowing Well**

Date Well Tested: \_\_\_\_\_ Duration of Pump Test (minimum 4 hours): \_\_\_\_\_ hours

Static Water Level (A): 38 Feet Below Land Surface Pumping Water Level (B): \_\_\_\_\_ Feet Below Land Surface

Drawdown [(B) - (A)]: \_\_\_\_\_ Feet Below Land Surface Test Pumping Rate: \_\_\_\_\_ Gallons Per Minute

Method of measurement (circle one): Steel tape  Electric tape  Air line  Other (describe): \_\_\_\_\_

**Pump Test Data for Flowing Well**

Measured shut in head: \_\_\_\_\_ feet.

Well yielded \_\_\_\_\_ GPM with a drawdown of \_\_\_\_\_ feet after \_\_\_\_\_ hours of pumping

OCT 08 2015

**Meter Installation**

Meter Manufacturer: \_\_\_\_\_ Meter Serial Number: \_\_\_\_\_

Meter Model Number/Name: \_\_\_\_\_ Type of Meter: \_\_\_\_\_

Totalizer Register Unit and Multiplier Factor (AF x .001, gal x 1000, etc): \_\_\_\_\_


Installation Date: \_\_\_\_\_ Meter installed by: \_\_\_\_\_

Is This Meter (circle one): New  Repaired  Replacement

*Important: By submitting the above information you are certifying that this meter was installed to manufacturer standards. For agricultural wells, a list of approved meters is on the MDEQ website.*

I HEREBY CERTIFY that the above statements are true to the best of my knowledge.


Tommy Peacock Sr #3409 9-12-15 Tommy Peacock Sr  
 Print Name of Pump Installer and License No. (if applicable) Date Signature of Pump Installer

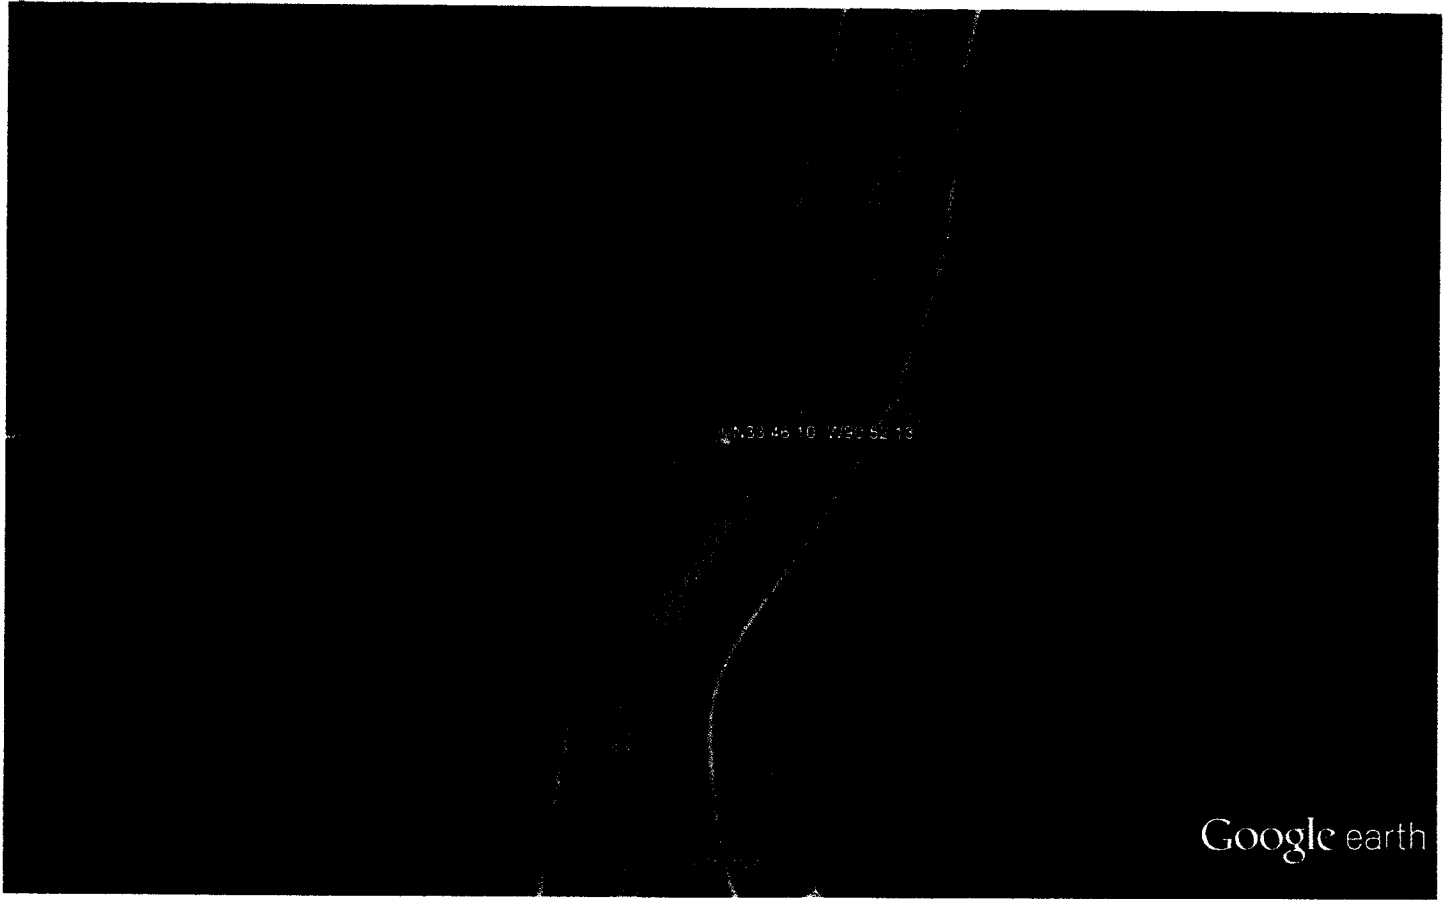

41.3346 10.7905213

Google earth

Google earth

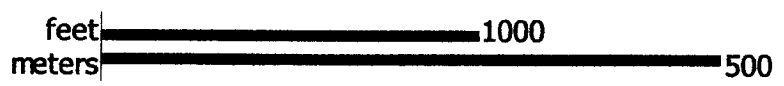

OCT 08 2015