

BOLIVAR MISSISSIPPI BOARD OF WATER COMMISSIONERS

K 2000
3-26-66

WATER WELL DRILLERS LOG

Date: 3/26, 1966, Driller: Bailey Drlg Co County Washington
(Name)

(1) Owner of Land:	Description & Color of Materials <small>(Sand, Clay, Red Clay, Shell, etc.)</small>	Thick- ness Feet	Depth Feet
(Name) <u>Benoit, Miss.</u>	<u>Clay</u>		<u>40</u>
(Address)	<u>Sand</u>		<u>120</u>
(2) Location: <u>1/4</u> , <u>1/4</u> , Sec. <u> </u> T. <u> </u> R. <u> </u>	<u>Gravel</u>		<u>160</u>
<u>8</u> miles <u>NE</u> of <u>Benoit</u> (distance) (direction) (Nearest Town)	<u>Mud</u>		<u>430</u>
(3) Topography: <u>Flat</u> (Hilly) (Flat) (Level)	<u>Sand</u>		<u>457</u>
(4) Purpose of Well: <u>Domestic</u> (Domestic Irrigation Municipal, Industrial, Other)	<u>Mud</u>		<u>461</u>
	<u>Sand</u>		<u>471</u>
	<u>Mud</u>		<u>481</u>
	<u>Sand</u>		<u>535</u>


Information upon completion of well:

- (1) Diameter 4X3 inches.
- (2) Total Depth 535 feet.
- (3) Water Level 24 feet below top of ground.
- (4) Cased to all way, Size 4X3.
- (5) Screen: Size 3", Length 30'.
- (6) Were any formations sealed against pollution?
 yes, X no.

If YES depth of formation _____

Why _____

Drillers Remarks: _____

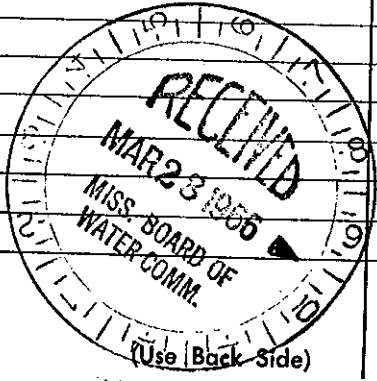

Well No. _____

Mail this copy to Board of Water Commissioners 429 Miss. St. Jackson, Miss.