

**BOLIVAR** MISSISSIPPI BOARD OF WATER COMMISSIONERS

*Coded*

**L 51**  
**2-17-61**


**WATER WELL DRILLERS LOG**

**CODED**

*L 500*

Date: Feb. 17, 19 61, Driller: Layne-Central Company County Bolivar  
(Name)

	Description & Color of Materials Sand, Clay, Red Clay, Shell, etc.	Thick- ness Feet	Depth Feet
(1) Owner of Land: <u>Dominic Rizzo</u> (Name) <u>Cleveland, Mississippi</u> (Address)	Clay	21	21
(2) Location: <u>1/4, 1/4, Sec. 10 T22N 6W</u>	Sand	54	75
Highway <u>#8</u> miles <u>west</u> of <u>Cleveland</u> (distance) (direction) (Nearest Town)	Sand & pea gravel	38	113
(3) Topography: <u>flat</u> (Hilly) (Flat) (Level)	Coarse sand	15	128
(4) Purpose of Well: <u>domestic</u> (Domestic Irrigation Municipal, Industrial, Other)	Sand and gravel	6	134
Information upon completion of well:	Coarse sand	6	140
(1) Diameter <u>4x3</u> inches.	Clay	33	173
(2) Total Depth <u>765</u> feet.	Sandy shale	45	218
(3) Water Level <u>16' 8"</u> feet below top of ground.	Sand	18	236
(4) Cased to <u>102'</u> , Size <u>4"</u>	Sand, strks. <u>clay</u>	41	277
(5) Screen: Size <u>3"</u> , Length <u>30'</u>	Sand	18	295
(6) Were any formations sealed against pollution? <u>X</u> yes, <u>      </u> no.	Sand, strks. shale	79	374
If YES depth of formation <u>packer just</u> above the screen.	Brown shale	10	384
Why _____	Sand	155	539
Drillers Remarks: _____	Fine sand, strks. shale	15	554
	Shale	88	642
	Shale, strks. fine sand	77	719
	Sand	46	765

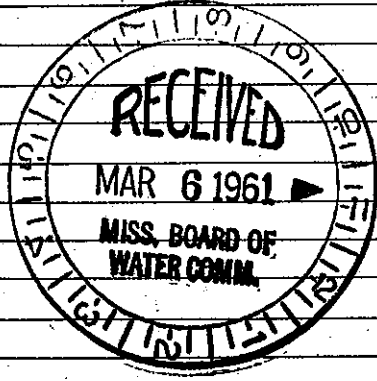

Well No.

(Use Back Side)

Mail this copy to Board of Water Commissioners 429 Miss. St. Jackson, Miss.