

**BOLIVAR** MISSISSIPPI BOARD OF WATER COMMISSIONERS

L-65

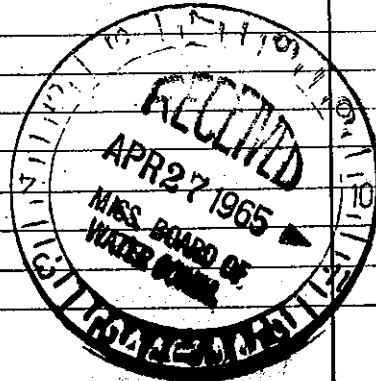
11-28-56

**WATER WELL DRILLERS LOG**

**CODED**

Date: Nov. 28, 1956, Driller: Layne-Central Company County Bolivar

(Name)

	Description & Color of Materials Sand, Clay, Red Clay, Shell, etc.	Thick- ness Feet	Depth Feet
(1) Owner of Land: <u>Cal Busby</u> (Name)	<u>Clay</u>	<u>15</u>	<u>15</u>
<u>Cleveland, Mississippi</u> (Address)	<u>Fine sand</u>	<u>20</u>	<u>35</u>
(2) Location: <u>1/4</u> , <u>1/4</u> , Sec. <u>7</u> <u>22 N 6 W</u> T. <u>R.</u>	<u>Coarse sand</u>	<u>11</u>	<u>46</u>
<u>2</u> miles <u>south</u> of <u>Pace</u> (distance) (direction) (Nearest Town)	<u>Fine sand</u>	<u>9</u>	<u>55</u>
(3) Topography: <u>flat</u> (Hilly) (Flat) (Level)	<u>Fine sand &amp; gravel</u>	<u>47</u>	<u>102</u>
(4) Purpose of Well: <u>irrigation</u> (Domestic Irrigation Municipal, Industrial, Other)	<u>Rock</u>		<u>102</u>
Information upon completion of well:			
(1) Diameter <u>16x12</u> inches.	<b>CODED</b>		
(2) Total Depth <u>102</u> feet.			
(3) Water Level <u>17'-3"</u> feet below top of ground.			
(4) Cased to <u>56'</u> , Size <u>16"</u> <u>2' swage</u>			
(5) Screen: Size <u>12"</u> , Length <u>45'</u>			
(6) Were any formations sealed against pollution? <u>no</u> yes, <u>no</u> no.			
If YES depth of formation _____			
Why _____			
Drillers Remarks: _____			
<u>1040 GPM</u>	Well No. _____		
<u>electric power</u>			

(Use Back Side)

Mail this copy to Board of Water Commissioners 429 Miss. St. Jackson, Miss.