

BOLIVAR

MISSISSIPPI BOARD OF WATER COMMISSIONERS

L-67

2-25-58

WATER WELL DRILLERS LOG

1/2/65
CODED 509

Date: Feb. 25, 1958, Driller: Layne-Central Company County Bolivar

MS-GW 9527

(Name)

(1) Owner of Land: Joe Aguzzi
(Name)

Cleveland, Mississippi
(Address)

(2) Location: 1/4, 1/4, Sec. 20 ²²⁰⁶ T R

4 miles west of Cleveland
(distance) (direction) (Nearest Town)

(3) Topography: flat
(Hilly) (Flat) (Level)

(4) Purpose of Well: irrigation
(Domestic Irrigation
Municipal, Industrial, Other)

Description & Color of Materials Sand, Clay, Red Clay, Shell, etc.	Thick- ness Feet	Depth Feet
Top sandy soil	5	5
Sandy red clay	31	36
Coarse sand & pea rock	36	72
Coarse sand & gravel	29	101
Coarse sand, clay balls & gravel	2	103
Sand & big gravel	9	112
Sand & big gravel	10	122

Information upon completion of well:

(1) Diameter 18 inches.

(2) Total Depth 122 feet.

(3) Water Level 14 feet below top of ground.

(4) Cased to 72', Size 18"

(5) Screen: Size 18", Length 50'

(6) Were any formations sealed against pollution?

no yes, no no.

If YES depth of formation _____


Why _____

Drillers Remarks: _____

3400 GPM

Electric power.

CODED

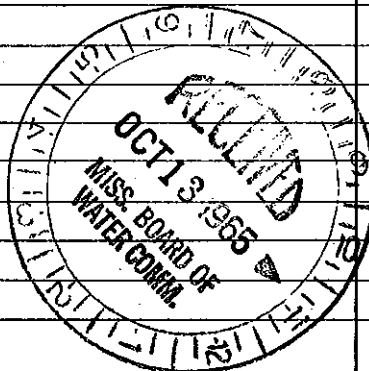

(Use Back Side)

Well No.

Mail this copy to Board of Water Commissioners 429 Miss. St. Jackson, Miss.