

Bolivar
L-69
4-60

MISSISSIPPI BOARD OF WATER COMMISSIONERS

WATER WELL DRILLERS LOG

1/27/66
823
CODED

Date: April 12, 1960, Driller: Layne-Central Company County Bolivar
(Name)

(1) Owner of Land: <u>Cal Busby</u> (Name)	Description & Color of Materials Sand, Clay, Red Clay, Shell, etc.	Thick- ness Feet	Depth Feet
<u>Cleveland, Mississippi</u> (Address)	Clay	16	16
Location: <u>7 226</u> <u>2</u> miles <u>south</u> of <u>Pace</u> (distance) (direction) (Nearest Town)	Coarse sand	34	50
(2) Topography: <u>flat</u> (Hilly) (Flat) (Level)	Coarse sand, pea gravel	25	75
(4) Purpose of Well: <u>irrigation</u> (Domestic Irrigation Municipal, Industrial, Other)	Pea gravel	27	102
Information upon completion of well:	Big rocks	10	112

CODED

(1) Diameter 16 inches.

(2) Total Depth 112 feet.

(3) Water Level 16 feet below top of ground.

(4) Cased to 62', Size 16"


(5) Screen: Size 16", Length 50'

(6) Were any formations sealed against pollution?
 yes, NO no.

If YES depth of formation _____

Why _____

Drillers Remarks:
Electric power.
2400 GPM.

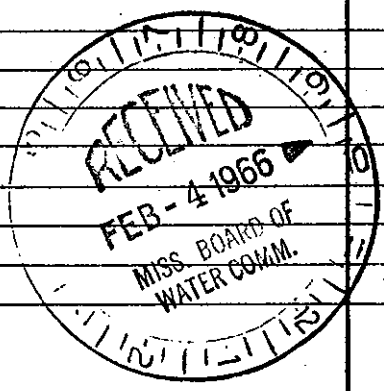

(Use Back Side)

Well No.

Mail this copy to Board of Water Commissioners 429 Miss. St. Jackson, Miss.