

BOLIVAR MISSISSIPPI BOARD OF WATER COMMISSIONERS

L-70

WATER WELL DRILLERS LOG

CODED

1-62

Date: January 19 62 Driller: Robert E. Rath County Polk

(1) Owner of Land: A. V. Henry
(Name)
Pace, Miss.
(Address)

(2) Location: 1/4, 1/4, Sec. 18 T22R6
6 miles SOUTH of PACE
(distance) (direction) (Nearest Town)

(3) Topography: Flat
(Hilly) (Flat) (Level)

(4) Purpose of Well: Domestic
(Domestic Irrigation Municipal, Industrial, Other)

Description & Color of Materials Sand, Clay, Red Clay, Shell, etc.	Thick- ness Feet	Depth Feet
<u>Shale + sand</u>	<u>0</u>	<u>200</u>
<u>Gumbo</u>	<u>200</u>	<u>235</u>
<u>sand</u>	<u>235</u>	<u>245</u>
<u>Gumbo</u>	<u>245</u>	<u>260</u>
<u>Shale + sand</u>	<u>260</u>	<u>300</u>
<u>Gumbo</u>	<u>300</u>	<u>440</u>
<u>Gumbo</u>	<u>440</u>	<u>450</u>
<u>sand</u>	<u>450</u>	<u>528</u>
<u>sand clay</u>	<u>528</u>	<u>768</u>
<u>sand</u>	<u>768</u>	<u>870</u>

Information upon completion of well:

(1) Diameter 3" inches.

(2) Total Depth 870 feet.

(3) Water Level 19' feet below top of ground.

(4) Cased to 870, Size 3X4

(5) Screen: Size 3", Length 20'


(6) Were any formations sealed against pollution?
 yes, no.

If YES depth of formation cased

Why _____

Drillers Remarks: _____

CODED

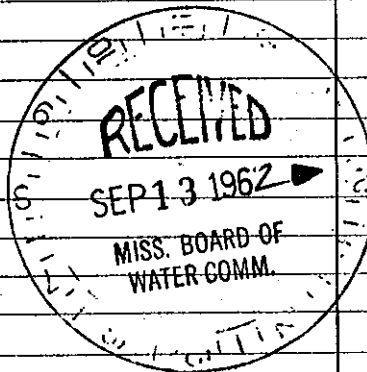

Well No.

(Use Back Side)

Mail this copy to Board of Water Commissioners 429 Miss. St. Jackson, Miss