

**BOLIVAR** MISSISSIPPI BOARD OF WATER COMMISSIONERS

**L 71**

**10-21-62 WATER WELL DRILLERS LOG**

Date: 10-21, 1962, Driller: BUTANE GAS CO **CODED** *Bolivar*

(Name)

(1) Owner of Land:	Description & Color of Materials Sand, Clay, Red Clay, Shell, etc.	Thick- ness Feet	Depth Feet
<u>GEO. WEBSTER</u> (Name)	<u>CLAY</u>	<u>1</u>	<u>15</u>
<u>SKENE, MISS</u> (Address)	<u>SAND (FINE)</u>	<u>20</u>	<u>35</u>
(2) Location: <u>1/4, 1/4, Sec. 32 T22R6</u>	<u>SAND COARSE</u>	<u>10</u>	<u>45</u>
<u>4 1/2</u> miles <u>WEST</u> of <u>SKENE</u>	<u>SAND + PEA ROCK</u>	<u>15</u>	<u>60</u>
(distance) (direction) (Nearest Town)	<u>SAND, PEA ROCK +</u>		
(3) Topography:	<u>GRAVEL</u>	<u>44</u>	<u>104</u>
(Hilly) (Flat) (Level)			
(4) Purpose of Well: <u>IRRIGATION</u>			
(Domestic Irrigation Municipal, Industrial, Other)			

Information upon completion of well:


- (1) Diameter 12" inches.
- (2) Total Depth 104 feet.
- (3) Water Level 15 feet below top of ground.
- (4) Cased to 56', Size 12"
- (5) Screen: Size 12", Length 48'
- (6) Were any formations sealed against pollution?  
 yes,  no.

If YES depth of formation \_\_\_\_\_

Why \_\_\_\_\_

Drillers Remarks: \_\_\_\_\_

**CODED**

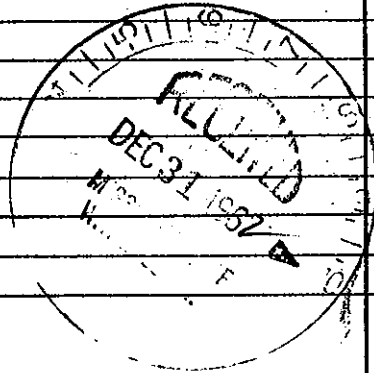

(Use Back Side)

Well No.

Mail this copy to Board of Water Commissioners 429 Miss. St. Jackson, Miss.