

**BOLIVAR** MISSISSIPPI BOARD OF WATER COMMISSIONERS

**RL-72**

**10-26-62 WATER WELL DRILLERS LOG**

*Bolivar*

Date: 10-26, 1962, Driller: BUTANE GAS CO County: LEFFLER

(Name)

(1) Owner of Land: HUNTON GRIFFITH  
(Name)  
SHENE, MISS  
(Address)

(2) Location: 1/4, 1/4, Sec. 31 R6  
5 miles WEST, of SHENE  
(distance) (direction) (Nearest Town)

(3) Topography: FLAT  
(Hilly) (Flat) (Level)

(4) Purpose of Well: DOMESTIC  
(Domestic Irrigation Municipal, Industrial, Other)

Description & Color of Materials Sand, Clay, Red Clay, Shell, etc.	Thick- ness Feet	Depth Feet
CLAY	18	18
SAND + CLAY	42	160
CLAY BLUE	57	217
STREAKED SAND + CLAY	101	318
SAND CLEAN	42	360
CLAY	220	580
SAND	40	620
CLAY (BLUE)	15	635
SAND	10	645
CLAY	25	670
SAND	15	685
CLAY	70	755
SCALE (BR)	10	765
CLAY	43	808
ROCK	6"	808-6
SAND	51-6	860

Information upon completion of well:

(1) Diameter: 4 1/2" inches.

(2) Total Depth: 860 feet.

(3) Water Level: 18 feet below top of ground.

(4) Cased to: 840, Size: 4 1/2"


(5) Screen: Size 2", Length 20'

(6) Were any formations sealed against pollution?  
 \_\_\_\_\_ yes, X no.

If YES depth of formation \_\_\_\_\_

Why \_\_\_\_\_

Drillers Remarks: \_\_\_\_\_

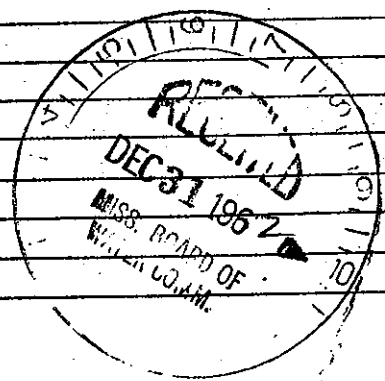

(Use Back Side)

Well No.

Mail this copy to Board of Water Commissioners 429 Miss. St. Jackson, Miss.