

**BOLIVAR MISSISSIPPI BOARD OF WATER COMMISSIONERS**

**L-73**

**7-22-64**

**WATER WELL DRILLERS LOG**

**CODED**

Date: 7-22, 1964, Driller: Dutton Well Supply Co.  
(Name)

(1) Owner of Land:	Description & Color of Materials Sand, Clay, Red Clay, Shell, etc.	Thick- ness Feet	Depth Feet
<u>J. R. Howarth Jr.</u> (Name) <u>R. F. D. Cleveland</u> (Address)	<u>Top soil sandy &amp; clay</u>	<u>21</u>	
(2) Location: <u>1/4</u> , <u>1/4</u> , Sec. <u>36</u> <u>22N 6W</u> T. <u>R.</u>	<u>Fine sand &amp; clay</u>	<u>96</u>	<u>67</u>
<u>1 1/2</u> miles <u>East</u> , of <u>Shene</u> (distance) (direction) (Nearest Town)	<u>Sand - m -</u>	<u>21</u>	<u>78</u>
(3) Topography: <input checked="" type="checkbox"/> (Hilly) <input type="checkbox"/> (Flat) <input type="checkbox"/> (Level)	<u>C sand &amp; gravel</u>	<u>49</u>	<u>127</u>
(4) Purpose of Well: <u>Irrigation</u> (Domestic, Irrigation, Municipal, Industrial, Other)			

Information upon completion of well:


- (1) Diameter 12 inches.
- (2) Total Depth 127 feet.
- (3) Water Level 19 feet below top of ground.
- (4) Cased to \_\_\_\_\_, Size \_\_\_\_\_.
- (5) Screen: Size 12, Length 40.
- (6) Were any formations sealed against pollution?  
\_\_\_\_\_ yes, \_\_\_\_\_ no.

If YES, depth of formation \_\_\_\_\_

Why \_\_\_\_\_

Drillers Remarks: \_\_\_\_\_

**CODED**

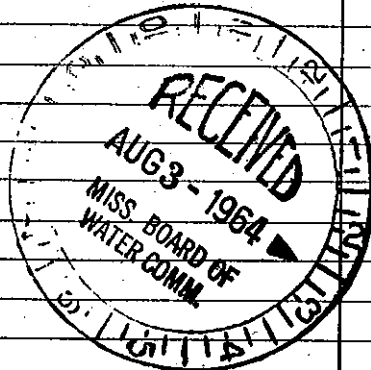

Well No.

(Use Back Side)

Mail this copy to Board of Water Commissioners 429 Miss. St. Jackson, Miss.