

BOLIVAR
L-74
1-6-65

MISSISSIPPI BOARD OF WATER COMMISSIONERS

WATER WELL DRILLERS LOG

Date: 1/6, 1965, Driller: Jetta Wells Supply County: Bolivar
 (Name)

CODED


(1) Owner of Land: J. H. Howarth Jr.
 (Name)
R. F. D. Cleveland, Miss.
 (Address)
 (2) Location: 1/4, 1/4, Sec. 35 T 22N R 6W
4 miles Southwest of Cleveland
 (distance) (direction) (Nearest Town)
 (3) Topography: ✓
 (Hilly) (Flat) (Level)
 (4) Purpose of Well: Domestic
 (Domestic Irrigation, Municipal, Industrial, Other)

Description & Color of Material Sand, Clay, Red Clay, Shell, etc.	Thickness Feet	Depth Feet
Top soil	16	
Sand Fine	24	40
1" + Gravel	95	135
Rock	3	138
Sand med	17	155
Rock	2	157
Clay	8	165
Sand Fine	125	290
Clay	24	314
Sand	116	430
Clay + shale	25	455
Sand Fine Rock	103	558
Clay + shale	102	660
Sand med	63	723

CODED

Information upon completion of well:

(1) Diameter 4 1/2 inches.
 (2) Total Depth 723 feet.
 (3) Water Level 23 feet below top of ground.
 (4) Cased to _____, Size _____
 (5) Screen: Size 2, Length 20
 (6) Were any formations sealed against pollution?
 _____ yes, _____ no.
 If YES depth of formation _____
 Why _____

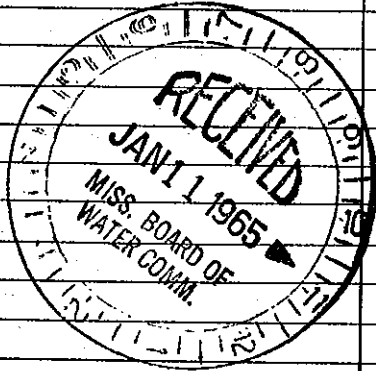

Drillers Remarks: _____

Well No. _____

(Use Back Side)

Mail this copy to Board of Water Commissioners 429 Miss. St. Jackson, Miss.