

BOLIVAR MISSISSIPPI BOARD OF WATER COMMISSIONERS

L-75

4-21-65 WATER WELL DRILLERS LOG

CODED

Date: 4/21, 1965, Driller: Delta Well Supply County: Bolivar
 MS-GW 5995 (Name)

(1) Owner of Land: <u>E. N. M. Knight</u> (Name)	Description & Color of Materials Sand, Clay, Red Clay, Shell, etc.	Thick- ness Feet	Depth Feet
<u>R.F.E. Cleveland</u> (Address)	<u>sound clay</u>	<u>24</u>	
(2) Location: <u>1/4, 1/4, Sec. 33, T22R6</u>	<u>fine sand</u>	<u>30</u>	<u>54</u>
<u>5</u> miles <u>North</u> of <u>Cleveland</u> (distance) (direction) (Nearest Town)	<u>Coast Sand</u>	<u>22</u>	<u>76</u>
(3) Topography: <input checked="" type="checkbox"/> (Level)	<u>sand & gravel</u>	<u>29</u>	<u>105</u>
(4) Purpose of Well: <u>Irrigation</u> (Domestic, Irrigation, Municipal, Industrial, Other)	<u>Bottom on rock</u>		

Information upon completion of well:

- (1) Diameter 12 inches.
- (2) Total Depth 105 feet.
- (3) Water Level 21 feet below top of ground.
- (4) Cased to _____, Size _____.
- (5) Screen: Size 12, Length 34.
- (6) Were any formations sealed against pollution?
 yes, no.

If YES depth of formation _____

Why _____


Drillers Remarks: _____

Yield in G. P. M.: 1650

Type power: Elec

Crops irrigated & Acreage: Rice

CODED

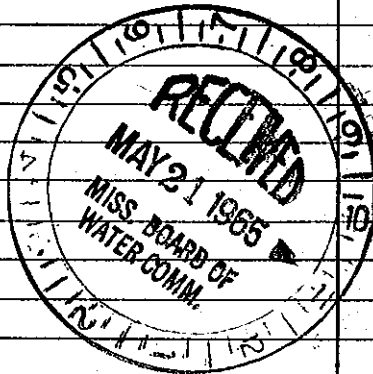

Well No.

(Use Back Side)

Mail this copy to Board of Water Commissioners 429 Miss. St. Jackson, Miss.