

BOLIVAR

MISSISSIPPI BOARD OF WATER COMMISSIONERS

L-76

4-26-65 WATER WELL DRILLERS LOG

Date: 4/26, 1965, Driller: Delta Well Supply Co. Bolivar

CODED

(1) Owner of Land: C.A. Russell
 (Name)
 Pace, Miss.
 (Address)

(2) Location: 1/4, 1/4, Sec. 7, T22R6
 2 miles So. of Pace
 (distance) (direction) (Nearest Town)

(3) Topography: (Level)
 (Hilly) (Flat)

(4) Purpose of Well: Irrigation
 (Domestic Irrigation, Municipal, Industrial, Other)

Description & Color of Materials Sand, Clay, Red Clay, Shell, etc.	Thick- ness Feet	Depth Feet
sand + clay	21	
fine sand	13	64
C. sand + gravel	52 1/2	120 1/2

CODED

Information upon completion of well:

(1) Diameter 18 inches.

(2) Total Depth 120 1/2 feet.

(3) Water Level 22 feet below top of ground.

(4) Cased to _____, Size _____

(5) Screen: Size 18, Length 40

(6) Were any formations sealed against pollution?
 _____ yes, _____ no.

If YES depth of formation _____


Why _____

Drillers Remarks: _____

Yield in G. P. M.: 2200

Type power: 40 H.P. Elec.

Crops irrigated & Acreage: Rice

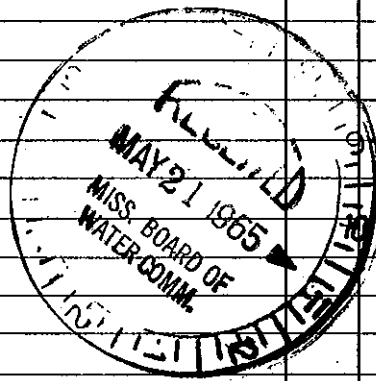

Well No.

(Use Back Side)

Mail this copy to Board of Water Commissioners 429 Miss. St. Jackson, Miss