

BOLIVAR MISSISSIPPI BOARD OF WATER COMMISSIONERS

L-78

10-3-65 WATER WELL DRILLERS LOG


Date: 10/3, 1965, Driller: Delta Well Supply Co. **CODED**

(1) Owner of Land: <u>Mrs C. W. Doty</u> (Name) <u>Cleveland</u> (Address)	Description & Color of Materials Sand, Clay, Red Clay, Shell, etc.	Thick- ness Feet	Depth Feet
	<u>Top soil</u>	<u>24</u>	
	<u>Clay & Sand Fine</u>	<u>46</u>	<u>70</u>
(2) Location: <u>1/4, 1/4, Sec. 24 T2R6</u> <u>1</u> miles <u>west</u> of <u>Cleveland</u> (distance) (direction) (Nearest Town)	<u>Sand Coarse</u>	<u>30</u>	<u>100</u>
	<u>" & Gravel</u>	<u>23</u>	<u>123</u>
(3) Topography: _____ (Hilly) (Flat) (Level)			
(4) Purpose of Well: <u>Irrigation</u> (Domestic, Irrigation, Municipal, Industrial, Other)			

Information upon completion of well:

- (1) Diameter 16 inches.
- (2) Total Depth 123 feet.
- (3) Water Level 19 feet below top of ground.
- (4) Cased to _____, Size _____
- (5) Screen: Size 16, Length 40
- (6) Were any formations sealed against pollution?
_____ yes, _____ no.

CODED

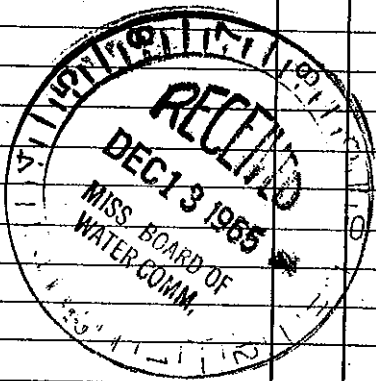

If YES depth of formation _____
Why _____
Drillers Remarks: _____

Yield in G. P. M.: 2500
Type power: 50 HP elec
Acres Irrigated & Acreage: 160 Rim

Well No. _____

(Use Back Side)

Mail this copy to Board of Water Commissioners 429 Miss. St. Jackson, Miss.