

BOLIVAR MISSISSIPPI BOARD OF WATER COMMISSIONERS

L-79

10-20-65 WATER WELL DRILLERS LOG

Date: 10/20, 1965, Driller: Dutton Well Supply **CODED**

LAND DIG

(1) Owner of Land: Landry & Cole
 (Name)
Skene
 (Address)

(2) Location: 1/4, 1/4, Sec. 33 T2R6,
2 miles west of Skene
 (distance) (direction) (Nearest Town)

(3) Topography: (Level)
 (Hilly) (Flat)

(4) Purpose of Well: Domestic
 (Domestic Irrigation, Municipal, Industrial, Other)

Description & Color of Materials Sand, Clay, Red Clay, Shell, etc.	Thick- ness Feet	Depth Feet
Top Soil	26	
Fine sand	20	46
Small gravel	100	146
Rock	2	148
Clay	92	240
F. sand	125	365
Clay & shale	50	415
F. sand	110	525
Clay	35	560
Fine sand	60	620
shale & clay	185	805
sand & mud	40	845

Information upon completion of well:

(1) Diameter: 4 1/2 inches.

(2) Total Depth: 839 feet.


(3) Water Level: 22 feet below top of ground.

(4) Cased to _____, Size _____.

(5) Screen: Size 2, Length 20 ft.

(6) Were any formations sealed against pollution?
 _____ yes, _____ no.

CODED

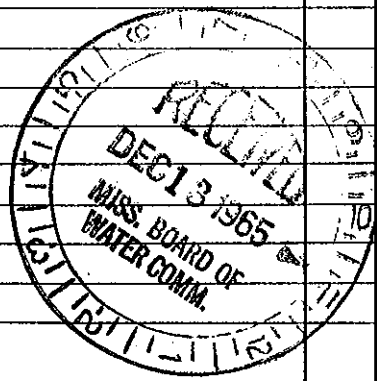

If YES depth of formation _____

Why _____

Drillers Remarks: _____

Yield in G. P. M.: 20

Type power: elec 1-HP

Crops irrigated & Acreage: _____

Well No.

(Use Back Side)

Mail this copy to Board of Water Commissioners 429 Miss. St. Jackson, Miss.