

**BOLIVAR MISSISSIPPI BOARD OF WATER COMMISSIONERS**

**L-80**

**2-15-66**

**WATER WELL DRILLERS LOG**

Date: 2-15, 1966, Driller: BUTANE GAS CO OF GREENWOOD County ORE

(Name)

**CODED**

	Description & Color of Materials Sand, Clay, Red Clay, Shell, etc.	Thick- ness Feet	Depth Feet
(1) Owner of Land: <u>NED FAORINELLI</u> (Name) <u>CLEVELAND, MISS.</u> (Address)	<u>0-10 CLAY</u>	<u>10</u>	<u>10</u>
	<u>38 SAND</u>	<u>29</u>	<u>38</u>
	<u>44 CLAY</u>	<u>6</u>	<u>44</u>
(2) Location: <u>1/4</u> , <u>1/4</u> , Sec. <u>14-TRR6</u> , <u>2 1/2</u> miles <u>WEST</u> of <u>CLEVELAND</u> (distance) (direction) (Nearest Town)	<u>130 SAND &amp; GRAVEL</u>	<u>86</u>	<u>130</u>
	<u>138 CLAY</u>	<u>8</u>	<u>138</u>
	<u>162 SIALCE</u>	<u>24</u>	<u>162</u>
(3) Topography: <u>FLAT</u> (Hilly) (Flat) (Level)	<u>163 ROLIC</u>	<u>1</u>	<u>163</u>
	<u>208 SHALE</u>	<u>45</u>	<u>208</u>
(4) Purpose of Well: <u>DOMESTIC</u> (Domestic Irrigation Municipal, Industrial, Other)	<u>540 SAND &amp; SHALE</u>	<u>332</u>	<u>540</u>
	<u>553 BROWN SHALE</u>	<u>13</u>	<u>553</u>
	<u>588 SAND &amp; SHALE</u>	<u>35</u>	<u>588</u>
	<u>720 Gummy SHALE</u>	<u>132</u>	<u>720</u>
	<u>851 SAND</u>	<u>131</u>	<u>851</u>

Information upon completion of well:

(1) Diameter 4x2 inches.

(2) Total Depth 839 feet.

(3) Water Level 27 feet below top of ground.

(4) Cased to 126' - 4", Size 2"

(5) Screen: Size 2", Length 20 FT.

(6) Were any formations sealed against pollution?  
 yes,  no.

If YES depth of formation \_\_\_\_\_

Why \_\_\_\_\_


Drillers Remarks: \_\_\_\_\_

Yield in G. P. M.: 18

Type power: ELECTRIC

Crops irrigated & Acreage: NONE

**Bottom CODED**

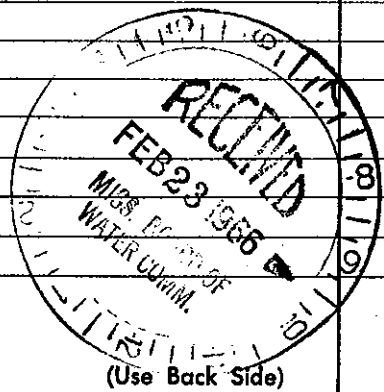

Well No.

Mail this copy to Board of Water Commissioners 429 Miss. St. Jackson, Miss.