

BOLIVAR MISSISSIPPI BOARD OF WATER COMMISSIONERS

L-81

3-22-66

WATER WELL DRILLERS LOG

CODES

Date: March 22, 1966, Driller: Butane Gas Co. of Greenwood Leflore County

(Name)

(1) Owner of Land: James Morgan
(Name)
Skene, Miss.
(Address)

(2) Location: 1/4, 1/4, Sec. 26 T22R6,
1 1/2 miles north of Skene
(distance) (direction) (Nearest Town)

(3) Topography: flat
(Hilly) (Flat) (Level)

(4) Purpose of Well: domestic
(Domestic Irrigation
Municipal, Industrial, Other)

Description & Color of Materials Sand, Clay, Red Clay, Shell, etc.	Thick- ness Feet	Depth Feet
clay	18	18
sand	46	64
sand & pea gravel	71	135
sandy clay	30	165
rock	1	166
sandy shale	78	244
rock	4	248
sandy shale	62	310
sand & shale st.	295	605
brown shale	23	628
sandy shale	17	645
gummy shale	94	739
sand shale st.	10	749
Sandy shale st.	54	903
CODED	31	934
D sand	21	955
D sand	30	995
gummy shale	84	1079
rock	1	1080
hard shale rock st.	92	1172
D sand	16	1198
Hard shale	57	1255
D sand	25	1280
rock	2	1282
hard shale	26	1308

Information upon completion of well:

(1) Diameter 4"x2" inches.

(2) Total Depth 1308 feet.

(3) Water Level flow feet below top of ground.

(4) Cased to 1280, Size 4 x 2

(5) Screen: Size 2, Length 20'

(6) Were any formations sealed against pollution?
yes, x no.

If YES depth of formation _____


Why _____

Drillers Remarks: _____

Yield in GPM: 18

Type Power: electric

Crops irrigated: none

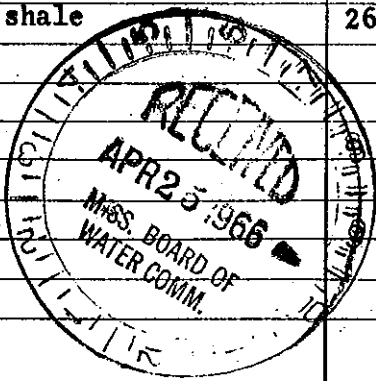

Well No.

(Use Back Side)

Mail this copy to Board of Water Commissioners 429 Miss. St. Jackson, Miss