

Bolivar
L-83
8-66

MISSISSIPPI BOARD OF WATER COMMISSIONERS

12/17/66
PR
CODED

WATER WELL DRILLERS LOG

Date: Aug. 20, 19 66, Driller: Layne-Central Company County Bolivar
(When well drilled) (Name) (Where well is located)

1) Owner of Land: Fioranelli Farms
(Name)
Cleveland, Mississippi
(Address)

2) Location: 1/4, 1/4, Sec. 14 T22R6,
3 miles west of Cleveland
(distance) (direction) (Nearest Town)

3) Topography: flat
(Hilly) (Flat) (Level)



4) Purpose of Well: irrigation
(Domestic Irrigation
Municipal, Industrial, Other)

Description & Color of Materials Sand, Clay, Red Clay, Shell, etc.	Thick- ness Feet	Depth Feet
Clay	16	16
Fine white sand	11	27
Coarse sand	12	39
Coarse sand, pea gravel	36	75
Coarse sand, gravel	31	106
Coarse sand, boulders		106

Information upon completion of well:

1) Diameter 18" inches.
2) Total Depth 112 feet.
3) Water Level _____ feet below top of ground.
4) Cased to 62', Size 18"
5) Screen: Size 18", Length 50'
slotted pipe
5) Were any formations sealed against pollution?
no yes, no no.
YES depth of formation _____
/ by _____
Drillers Remarks: _____
Yield in gpm: _____
Size pump: _____
Type power: _____

CODED

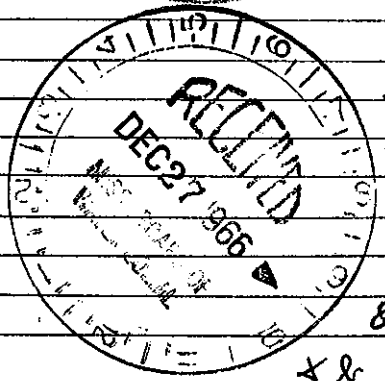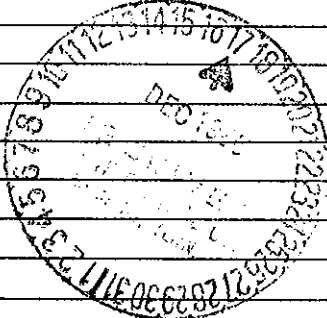

Handwritten symbols and initials: +, x, &, y, &, +, &

Mail this copy to Board of Water Commissioners 429 Miss. St. Jackson, Miss.