

Bolivar
L-84
8-66

MISSISSIPPI BOARD OF WATER COMMISSIONERS

12/17/66

WATER WELL DRILLERS LOG

CODED BOOK

Date: Aug. 28, 1966, Driller: Layne-Central Company County Bolivar
(When well drilled) (Name) (Where well is located)

1) Owner of Land: J. & V. Aguzzi
(Name)
Cleveland, Mississippi
(Address)

2) Location: 1/4, 1/4, Sec. 22 ^{22N6W} T R
3 1/4 miles west of Cleveland
(distance) (direction) (Nearest Town)

3) Topography: flat
(Hilly) (Flat) (Level)

4) Purpose of Well: irrigation
(Domestic Irrigation Municipal, Industrial, Other)

Description & Color of Materials Sand, Clay, Red Clay, Shell, etc.	Thick- ness Feet	Depth Feet
Clay	17	17
Fine sand	10	27
Coarse sand	13	40
Coarse sand, pea gravel	35	75
Coarse sand, gravel	32	107
Boulders	5	112

CODED

Information upon completion of well:

1) Diameter 18 inches.

2) Total Depth 112 feet.

3) Water Level _____ feet below top of ground.

4) Cased to 62' Size 18" slotted pipe

5) Screen: Size 18", Length 50'

6) Were any formations sealed against pollution?
 _____ yes, no no.



YES depth of formation _____
 why _____

Drillers Remarks: _____

yield in gpm: _____

size pump: _____

Type power: _____

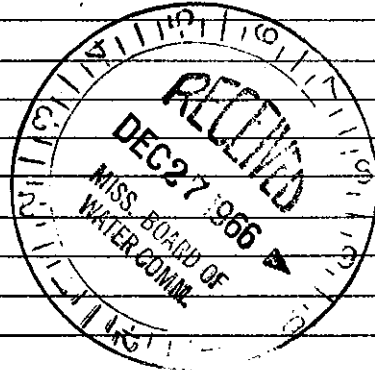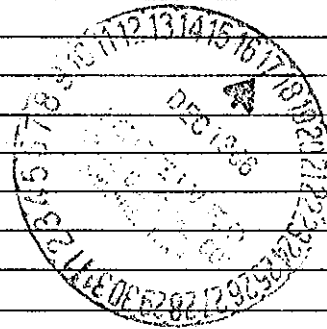

Mail this copy to Board of Water Commissioners 429 Miss. St. Jackson, Miss.