

BOLIVAR MISSISSIPPI BOARD OF WATER COMMISSIONERS

L 85
10-16-62

WATER WELL DRILLERS LOG

CODED

Date: 10-16, 1962, Driller: PUTNEY GAS CO County: PUTNEY
(Name)

(1) Owner of Land: <u>MILTON GRIFFITH</u> (Name)	Description & Color of Materials Sand, Clay, Red Clay, Shell, etc.	Thick- ness Feet	Depth Feet
<u>SKENE, MISS.</u> (Address) <u>4 215</u>	<u>CLAY</u>	<u>15</u>	<u>15</u>
(2) Location: <u>1/4</u> , <u>1/4</u> , Sec. <u>31 T22R6</u>	<u>SAND</u>	<u>45</u>	<u>60</u>
<u>6</u> miles <u>SW</u> of <u>SKENE</u> (distance) (direction) (Nearest Town)	<u>SAND & GRAVEL</u>	<u>75</u>	<u>135</u>
(3) Topography: <u>FLAT</u> (Hilly) (Flat) (Level)	<u>BLUE CLAY</u>	<u>135</u>	<u>270</u>
(4) Purpose of Well: <u>DOMESTIC</u> (Domestic Irrigation Municipal, Industrial, Other)	<u>SAND (WHITE)</u>	<u>91</u>	<u>361</u>
	<u>CLAY</u>	<u>5</u>	<u>366</u>
	<u>SAND</u>	<u>244</u>	<u>610</u>
	<u>CLAY</u>	<u>60</u>	<u>670</u>
	<u>SAND & SHALE</u>	<u>60</u>	<u>710</u>
	<u>SAND (WHITE)</u>	<u>15</u>	<u>725</u>
	<u>SAND (WHITE)</u>	<u>38</u>	<u>763</u>

Information upon completion of well:


- (1) Diameter 4"x2" inches.
- (2) Total Depth 760' feet.
- (3) Water Level 15' feet below top of ground.
- (4) Cased to 740', Size 4"x2"
- (5) Screen: Size 2", Length 20'
- (6) Were any formations sealed against pollution?
_____ yes, X no.

If YES depth of formation _____

Why _____

Drillers Remarks: _____

CODED

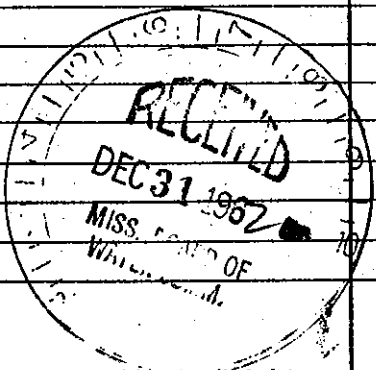

(Use Back Side)

Well No.

Mail this copy to Board of Water Commissioners 429 Miss. St. Jackson, Miss.