

BOLIVAR MISSISSIPPI BOARD OF WATER COMMISSIONERS

DL 86  
1-66

WATER WELL DRILLERS LOG


**CODED**

Date: 1/30, 1966, Driller: Foster Well Supply  
(Name)

LANDIG

(1) Owner of Land:	Description & Color of Materials Sand, Clay, Red Clay, Shell, etc.	Thick-ness Feet	Depth Feet
<u>Cole &amp; Landig</u> (Name)			
<u>Shone</u> (Address)	<u>Top soil</u>	<u>19</u>	
	<u>sub soil</u>	<u>20</u>	<u>41</u>
(2) Location: <u>1/4</u> , <u>1/4</u> , Sec. <u>33</u> T <u>22</u> R <u>6</u>	<u>4 shells</u>	<u>33</u>	<u>74</u>
<u>2</u> miles <u>S. 70</u> , of <u>Shone</u> (distance) (direction) (Nearest Town)	<u>4 gravel</u>	<u>55</u>	<u>129</u>
(3) Topography: <input checked="" type="checkbox"/> (Hilly) <input type="checkbox"/> (Flat) <input type="checkbox"/> (Level)			
(4) Purpose of Well: <u>Irrigation</u> (Domestic Irrigation, Municipal, Industrial, Other)			
Information upon completion of well:			
(1) Diameter <u>16</u> inches.			
(2) Total Depth <u>129</u> feet.			
(3) Water Level <u>14</u> feet below top of ground.			
(4) Cased to _____, Size _____			
(5) Screen: Size <u>16</u> , Length <u>40</u>			
(6) Were any formations sealed against pollution? _____ yes, _____ no.			
If YES depth of formation _____			
Why _____			
Drillers Remarks: _____			

**CODED**

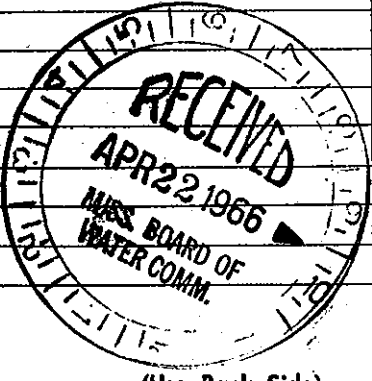

Well No.

(Use Back Side)

Mail this copy to Board of Water Commissioners 429 Miss. St. Jackson, Miss.