

BOLIVAR
L 93
6-1-61

MISSISSIPPI BOARD OF WATER COMMISSIONERS

WATER WELL DRILLERS LOG

coded
CODED
for
L 93

Date: June 1, 1961, Driller: Layne-Central Company County Bolivar
 (Name)

(1) Owner of Land: <u>Joe Aguzzi</u> (Name)	Description & Color of Materials Sand, Clay, Red Clay, Shell, etc.	Thick- ness Feet	Depth Feet
<u>Cleveland, Mississippi</u> (Address)	Clay	12	12
<u>22N</u>	Coarse sand	24	36
(2) Location: <u>1/4, 1/4, Sec. 15 T. 6W,</u>	Coarse sand, lignite	14	50
<u>1</u> miles <u>northwest</u> of <u>Cleveland</u>	Coarse sand, pea gravel	22	72
(distance) (direction) (Nearest Town)	Gravel	36	108
(3) Topography: <u>flat</u>			
(Hilly) (Flat) (Level)			
(4) Purpose of Well: <u>irrigation</u> (Domestic Irrigation Municipal, Industrial, Other)			

CODED

Information upon completion of well:

(1) Diameter 12 inches.

(2) Total Depth 108 feet.

(3) Water Level 16' - 8" feet below top of ground.

(4) Cased to 58', Size 12"


(5) Screen: Size 12", Length 50'

(6) Were any formations sealed against pollution?
 _____ yes, X no.

If YES depth of formation _____

Why _____

Drillers Remarks: _____

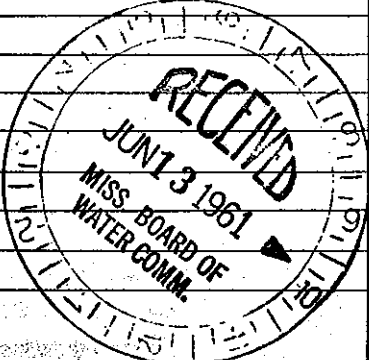

(Use Back Side)

Well No.

Mail this copy to Board of Water Commissioners 429 Miss. St. Jackson, Miss.