

BOLIVAR MISSISSIPPI BOARD OF WATER COMMISSIONERS coded

L 99
3-7-62


WATER WELL DRILLERS LOG

CODED C 1258 R
3/7/62
JMM

Date: March 7, 1962, Driller: Layne-Central Company County Bolivar

(Name)

(1) Owner of Land: <u>Dominic P. Rizzo</u> (Name)	Description & Color of Materials Sand, Clay, Red Clay, Shell, etc.	Thick- ness Feet	Depth Feet
<u>Cleveland, Mississippi</u> (Address)	Clay	18	18
(2) Location: <u>1/4</u> , <u>1/4</u> , Sec. <u>20</u> T <u>22N</u> R <u>6W</u>	Fine sand	17	35
<u>4</u> miles <u>west</u> of <u>Cleveland</u> (distance) (direction) (Nearest Town)	Coarse sand	27	62
(3) Topography: <u>flat</u> (Hilly) (Flat) (Level)	Coarse sand, pea gravel	30	92
(4) Purpose of Well: <u>irrigation</u> (Domestic Irrigation Municipal, Industrial, Other)	Coarse sand, gravel	20	112
CODED			
Information upon completion of well:			
(1) Diameter <u>18</u> inches.			
(2) Total Depth <u>112</u> feet.			
(3) Water level <u>15</u> feet below top of ground.			
(4) Cased to <u>62'</u> , Size <u>18"</u>			
(5) Screen: Size <u>18"</u> , Length <u>50'</u>			
(6) Were any formations sealed against pollution?			
<u>no</u> yes, <u>no</u> no.			
If YES depth of formation _____			
Why _____			
Drillers Remarks: _____			

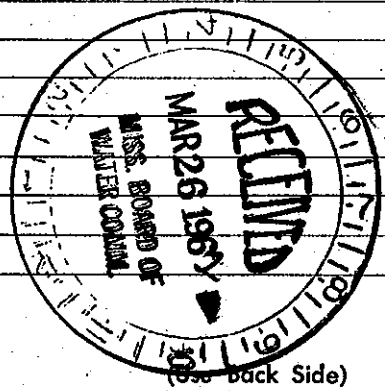

Well No.

Mail this copy to Board of Water Commissioners 429 Miss. St. Jackson, Miss