

BOLIVAR MISSISSIPPI BOARD OF WATER COMMISSIONERS Coded

L 100
1-11-63


WATER WELL DRILLERS LOG

CODED
C 1473R

Date: January 11, 1963, Driller: Layne-Central Company County Bolivar

(Name)

	Description & Color of Materials Sand, Clay, Red Clay, Shell, etc.	Thick- ness Feet	Depth Feet
(1) Owner of Land: <u>Fioranelli Farms</u> (Name) <u>Cleveland, Mississippi</u> (Address)	Clay	14	14
(2) Location: <u>1/4, 1/4, Sec. 14 T. 22 N. R. 6 W.</u> <u>5 miles west of Cleveland,</u> (distance) (direction) (Nearest Town)	Coarse sand	22	36
	Coarse sand, pea gravel	36	72
	Gravel and sand	40	112
(3) Topography: <u>flat</u> (Hilly) (Flat) (Level)	CODED		
(4) Purpose of Well: <u>irrigation</u> (Domestic Irrigation Municipal, Industrial, Other)			
Information upon completion of well:			
(1) Diameter <u>18</u> inches.			
(2) Total Depth <u>112</u> feet.			
(3) Water Level <u>16' - 4"</u> feet below top of ground.			
(4) Cased to <u>63'</u> , Size <u>18"</u>			
(5) Screen: Size <u>18"</u> , Length <u>50'</u>			
(6) Were any formations sealed against pollution? <u>no</u> yes, <u>no</u> no.			
If YES depth of formation _____			
Why _____			
Drillers Remarks: _____			

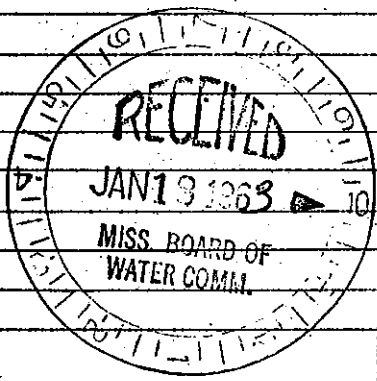

Well No.

(Use Back Side)

Mail this copy to Board of Water Commissioners 429 Miss. St. Jackson, Miss