

BOLIVAR MISSISSIPPI BOARD OF WATER COMMISSIONERS *Coded*

L 102
4-8-61

WATER WELL DRILLERS LOG

~~CODED~~

Date: 4/8, 1961, Driller: Delta Well Supply Co. County Bolivar
(Name)

(1) Owner of Land: <u>Joe B. Dakin</u> (Name)	Description & Color of Materials Sand, Clay, Red Clay, Shell, etc.	Thick- ness Feet	Depth Feet
<u>Cleveland</u> (Address)	<u>Top soil + sand</u>	<u>16</u>	<u>16</u>
(2) Location: <u>1/4</u> , <u>1/4</u> , Sec. <u>36</u> , T. <u>23</u> , R. <u>6</u>	<u>Gravel sand</u>	<u>22</u>	<u>38</u>
<u>3</u> miles <u>So. West</u> of <u>Cleveland</u> (distance) (direction) (Nearest Town)	<u>Sand + gravel</u>	<u>869</u>	<u>1249</u>
(3) Topography: <u>Flat</u> (Hilly) (Flat) (Level)			
(4) Purpose of Well: (Domestic Irrigation Municipal, Industrial, Other)	CODED		


Information upon completion of well:

- (1) Diameter 12 inches.
- (2) Total Depth 1249 feet.
- (3) Water Level 15 feet below top of ground.
- (4) Cased to _____, Size _____.
- (5) Screen: Size 12, Length 40 ft.
- (6) Were any formations sealed against pollution?
_____ yes, no.

If YES depth of formation _____

Why _____

Drillers Remarks: _____

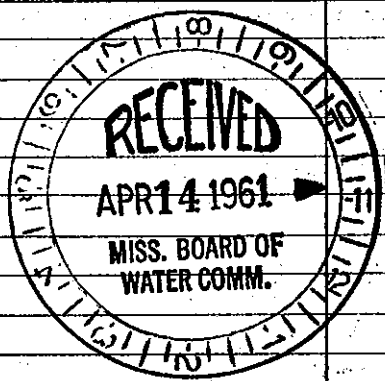

(Use Back Side)

Well No

Mail this copy to Board of Water Commissioners 429 Miss. St. Jackson, Miss