


**Bolivar**  
**L 112**  
**5-24-74**

MISSISSIPPI  
 BOARD OF WATER COMMISSIONERS CODED  
 416 North State Street  
 Jackson, Mississippi 39201

WATER WELL DRILLERS LOG

5/24 1974 *Pittman Drilling Co* Bolivar  
 date well completed firm name county well located

LANDOWNER:	description of formations encountered	from	to
(mailing address)			
<i>Hardy Farms</i>	<i>Top soil</i>	<i>0</i>	<i>19</i>
<i>W Cleveland</i>	<i>Clay</i>	<i>19</i>	<i>35</i>
	<i>Blue clay</i>	<i>35</i>	<i>45</i>
	<i>Sand</i>	<i>45</i>	<i>80</i>
	<i>Sand &amp; gravel</i>	<i>80</i>	<i>113</i>
	<i>Clay</i>	<i>113</i>	<i>?</i>
WELL LOCATION:			
sec. <i>13</i> T. <i>22</i> N R. <i>6</i> W			
<i>3</i> miles <i>east</i> of <i>Cleveland</i>			
(distance) (direction) (nearest town)			
WELL PURPOSE: <i>Irrigation</i>			
(home, irrigation, municipal, industrial)			
WELL COMPLETION DATA:			
(1) diameter (inches) <i>12"</i>			
(2) total depth (feet) <i>113</i>			
(3) static water level (feet) <i>22</i> below top of ground			
(4) casing <i>steel</i> (material) (depth)			
(size) If telescope see back.			
(5) screen <i>36 ft</i> (length) (depth to top)			
<i>12"</i> (size) <i>steel</i> (material)			
(6) pump <i>25</i> (HP) <i>1800</i> (yield gpm)			
<i>Diesel</i> (type power)			
(7) electric log <i>no</i> (yes or no)			
(organization running log)			
(8) how well bottom plugged <i>steel plate</i>			

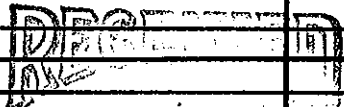

JUN 24 1974

MISS. BD. OF WATER COMM