

Bolivar
 L 119
 8-68

MISSISSIPPI
 BOARD OF WATER COMMISSIONERS
 406 North State Street
 Jackson, Mississippi 39201

WATER WELL DRILLERS LOG

Aug 24 1968 Delta Well Bolivar
 date well completed firm name county well located

LANDOWNER: John Bowman

description of formations
 encountered

from to

Paee, Miss.

(mailing address)

WELL LOCATION:

sec. 6 T. 22 N R. 6 W
 1 miles West of Paee
 (distance) (direction) (nearest town)


WELL PURPOSE: Home
 (home, irrigation, municipal, industrial)

WELL COMPLETION DATA:

- (1) diameter (inches) 4" 12'
- (2) total depth (feet) 933
- (3) static water level (feet) 26 below top of ground.
- (4) casing Galv (material) (depth)
 Yes If telescope see back.
 (size)
- (5) screen 20 (length) (depth to top)
 2" Stainless (size) (material)
- (6) pump 1/2 (HP) 14 (yield gpm)
 Elec (type power)
- (7) electric log No (yes or no)
 (organization running log)
- (8) how well bottom plugged S/W

description of formations encountered	from	to
Clay	0	18
Sand	18	147
Clay	147	180
Sand	180	231
Clay streak	231	265
Sand	265	526
Clay + Shale	526	530
Sand	530	661
Shale + Clay	661	723
Sand	723	766
Clay	766	826
Sand, Shale	826	889
Sand	889	951

DED.

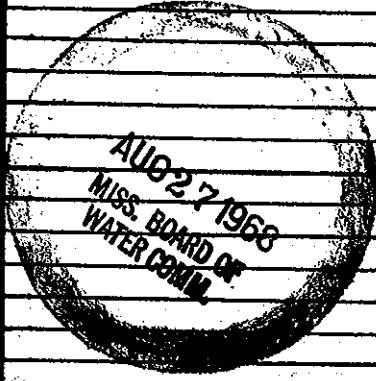

DRILLERS REMARKS: