


BOLIVAR MISSISSIPPI BOARD OF WATER COMMISSIONERS

L 131
5-6-63

WATER WELL DRILLERS LOG

Date: 5/6, 1963, Driller: Delton W. COOPER County Bolivar
(Name)

(1) Owner of Land: <u>Cal Baister</u> (Name)	Description & Color of Materials Sand, Clay, Red Clay, Shell, etc.	Thick- ness Feet	Depth Feet
<u>Sherrill</u> (Address)	<u>COOPER</u>	10	20
(2) Location: <u>1/4</u> , <u>1/4</u> , Sec. <u>7</u> T <u>22</u> R <u>6</u> N	<u>Clay</u>	5	30
<u>2</u> miles <u>South</u> , of <u>Peace</u> (distance) (direction) (Nearest Town)	<u>fine sand</u>	15	50
(3) Topography: <input checked="" type="checkbox"/> (Hilly) <input type="checkbox"/> (Flat) <input type="checkbox"/> (Level)	<u>course sand</u>	50	100
(4) Purpose of Well: <u>Irrigation</u> (Domestic Irrigation, Municipal, Industrial, Other)	<u>hard sand</u>	10	110
Information upon completion of well:	<u>COOPER</u>	200	130.5
(1) Diameter <u>12</u> inches.	<u>COOPER</u>		
(2) Total Depth <u>133.5</u> feet.	<u>COOPER</u>		
(3) Water Level <u>21</u> feet below top of ground.	<u>COOPER</u>		
(4) Cased to _____, Size _____	<u>COOPER</u>		
(5) Screen: Size <u>12</u> , Length <u>40 ft</u>	<u>COOPER</u>		
(6) Were any formations sealed against pollution? <u>no</u>	<u>COOPER</u>		
If YES, depth of formation _____	<u>COOPER</u>		
Why _____	<u>COOPER</u>		
Drillers Remarks: _____	<u>COOPER</u>		
_____	<u>COOPER</u>		
_____	<u>COOPER</u>		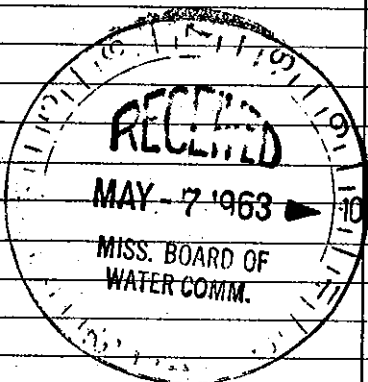
Well No.

(Use Back Side)

Mail this copy to Board of Water Commissioners 429 Miss. St. Jackson, Miss.