

BOLIVAR MISSISSIPPI BOARD OF WATER COMMISSIONERS

L 132
5-10-63

WATER WELL DRILLERS LOG

5/15/63
1522

Date: May 10, 19 63, Driller CODED Layne-Central Company County Bolivar
(Name)

(1) Owner of Land: McWilliams & King
(Name)
Cleveland, Mississippi
(Address) T22N

(2) Location: 1/4, 1/4, Sec. 34 T. R. 6W
6 miles west of Cleveland
(distance) (direction) (Nearest Town)

(3) Topography: flat
(Hilly) (Flat) (Level)

(4) Purpose of Well: domestic
(Domestic Irrigation
Municipal, Industrial, Other)

| Description & Color of Materials Sand, Clay, Red Clay, Shell, etc. | Thick- ness Feet | Depth Feet |
|---|------------------------|---------------|
| Clay | 12 | 12 |
| Sand | 23 | 35 |
| Coarse sand | 25 | 60 |
| Coarse sand & pea gravel | 49 | 109 |
| Coarse sand | 7 | 116 |
| Coarse sand & gravel | 28 | 134 |
| Clay | 98 | 232 |
| Shale | 19 | 251 |
| Sand | 77 | 328 |
| Shale | 25 | 353 |
| Sand | 79 | 432 |
| Shale streaks sand | 39 | 471 |
| Sand | 119 | 590 |

Information upon completion of well:

(1) Diameter 4x3 inches.

(2) Total Depth 590'6" feet.

(3) Water Level 14'8" feet below top of ground.

(4) Cased to 98'9" Size 4"
458'2" Size 3"


(5) Screen: Size 3", Length 30'4"

(6) Were any formations sealed against pollution?
yes yes, no no.

If YES depth of formation Packer type seal
Mechanical seal in the bottom.

Why _____

Drillers Remarks: _____

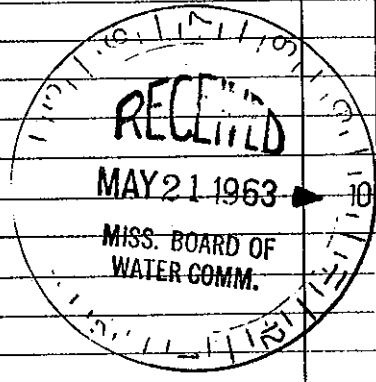

Well No.

(Use Back Side)

Mail this copy to Board of Water Commissioners 429 Miss. St. Jackson, Mis