


Bolivar MISSISSIPPI BOARD OF WATER COMMISSIONERS

L 136 CODED  
9-66 WATER WELL DRILLERS LOG CODED

Date: 9/14, 1966, Driller: John W. Bell County: Salmon  
(Name)

(1) Owner of Land: <u>Mrs. C.W. Darty</u> (Name)	Description & Color of Materials Sand, Clay, Red Clay, Shell, etc.	Thick- ness Feet	Depth Feet
<u>R.S. Cleveland</u> (Address)	<u>Top. sand &amp; clay</u>		<u>16</u>
(2) Location: <u>NE 1/4, NW 1/4, Sec. 24 T22R6W</u>	<u>Fine sand</u>	<u>30</u>	<u>46</u>
<u>1 1/2</u> miles <u>West</u> of <u>Cleveland</u> (distance) (direction) (Nearest Town)	<u>Coarse sand &amp; gravel</u>	<u>29</u>	<u>135</u>
(3) Topography: <input checked="" type="checkbox"/> (Hilly) <input type="checkbox"/> (Flat) <input type="checkbox"/> (Level)	<u>Clay hard</u>	<u>50</u>	<u>185</u>
(4) Purpose of Well: <u>Domestic</u> (Domestic Irrigation, Municipal, Industrial, Other)	<u>Shard fine</u>	<u>110</u>	<u>295</u>
Information upon completion of well:	<u>Clay soft</u>	<u>20</u>	<u>315</u>
(1) Diameter: <u>4 1/2</u> inches.	<u>Shard fine</u>	<u>75</u>	<u>390</u>
(2) Total Depth: <u>796</u> feet.	<u>Clay soft</u>	<u>23</u>	<u>413</u>
(3) Water Level: <u>22</u> feet below top of ground.	<u>Shale &amp; shale breaks.</u>	<u>172</u>	<u>585</u>
(4) Cased to: <u>125'</u> <u>4"</u> Size: <u>2"</u>	<u>shale hard</u>	<u>125</u>	<u>710</u>
(5) Screen: Size: <u>2</u> , Length: <u>20 ft.</u>	<u>Rock</u>	<u>2</u>	<u>712</u>
(6) Were any formations sealed against pollution? _____ yes, _____ no.	<u>Clay</u>	<u>33</u>	<u>745</u>
If YES depth of formation _____	<u>coarse to med. sand</u>	<u>52</u>	<u>797</u>
Why _____	<u>Clay</u>	<u>8</u>	
Drillers Remarks: _____	<u>Fine sand</u>	<u>10</u>	
_____	<u>Clay</u>	<u>?</u>	
_____			
_____			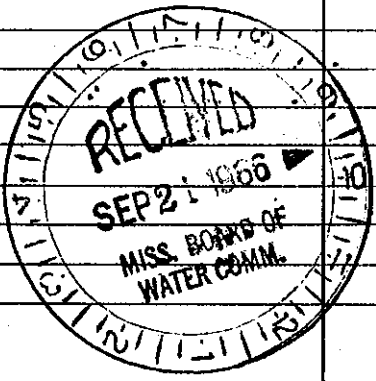
(Use Back Side)

Well No.

Mail this copy to Board of Water Commissioners 429 Miss. St. Jackson, Mis: