

CODED

Bolivar
L 140
3-67

MISSISSIPPI
BOARD OF WATER COMMISSIONERS
416 North State Street
Jackson, Mississippi 39201

8/24/67
CJ 2402
Well #1

WATER WELL DRILLERS LOG

March 14, 1967 Layne-Central Company Bolivar
date well completed firm name county well located

LANDOWNER: E. A. Lyons

Cleveland, Mississippi
(mailing address)


WELL LOCATION:
sec. 23 T. 22 N. R. 6 E
S W
3 miles west of Cleveland
(distance) (direction) (nearest town)

description of formations encountered	from	to
Clay	0	22
Coarse sand	22	48
Coarse sand, pea gravel	48	78
Coarse sand, pea gravel and bigger gravel	78	117

WELL PURPOSE: irrigation
(home, irrigation, municipal, industrial)

CODED

WELL COMPLETION DATA:
(1) diameter (inches) 16
(2) total depth (feet) 117
(3) static water level (feet) 20' 6" ~~20' 6"~~ above top of ground.
(4) casing steel, 67'
(material) (depth)
16" if telescope see back.
(size)
(5) screen 50', 117'
(length) (depth to top)
16" Armco
(size) (material)
(6) pump _____
(HP) (yield gpm)
(type power)
(7) electric log no
(yes or no)
No other information
(organization running log)
available
(8) how well bottom plugged plate

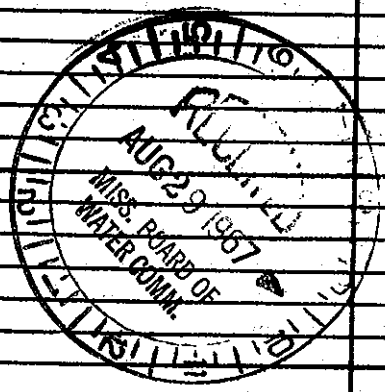

DRILLERS REMARKS: