

CODED

CODED

Bolivar  
L 142  
6-67

MISSISSIPPI  
BOARD OF WATER COMMISSIONERS  
416 North State Street  
Jackson, Mississippi 39201

WATER WELL DRILLERS LOG

June 21 19 67 Dyer Well & Irr. Ser. Bolivar  
date well completed firm name county well located

LANDOWNER: J. H. Howarth Jr.

R. R. Cleveland.

Miss (mailing address)

WELL LOCATION:

sec. 25 T 22 N R. 6 E  
W

2 miles N. W. of Skene  
(distance) (direction) (nearest town)


WELL PURPOSE: Irrigation  
(home, irrigation, municipal, industrial)

WELL COMPLETION DATA:

- (1) diameter (inches) 12"
- (2) total depth (feet) 113'
- (3) static water level (feet) 17' below top of ground.
- (4) casing Blk. Ir. 73'  
(material) (depth)  
(size) if telescope see back.
- (5) screen 40' 73'  
(length) (depth to top)  
12" Blk. Ir.  
(size) (material)
- (6) pump 28 1500  
(HP) (yield gpm)  
tractor  
(type power)
- (7) electric log \_\_\_\_\_  
(yes or no)  
(organization running log)
- (8) how well bottom plugged Plate  
welded on bottom

description of formations encountered	from	to
Hard Clay	0	13
Fine Sand	13	43
Coarse sand & gra.	43	53
Med. Sand	53	63
Coarse Sand	63	73
Med Sand	73	83
Coarse Sand	83	93
Fine Sand	93	103
Coarse Sand & Gra.	103	113

CODED

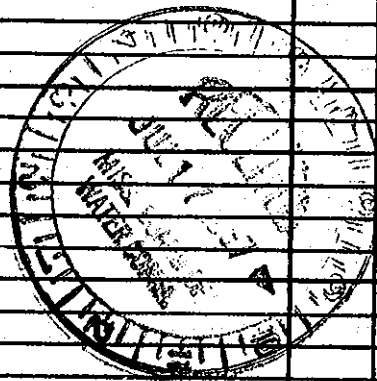

DRILLERS REMARKS: