

CODED

MISSISSIPPI BOARD OF WATER COMMISSIONERS
416 North State Street
Jackson, Mississippi 39201

CODED

WATER WELL DRILLERS LOG

Belivar
L 143
1-68

1/25/68 19 *Dutton Well Supply Co* Belivar
date well completed firm name county well located

LANDOWNER:

Beady Cole

R. J. Boyle, Miss.
(mailing address)

WELL LOCATION:

sec. *23* T. *23* N. R. *6* W.

3 miles *West* of *Cleveland*
(distance) (direction) (nearest town)

WELL PURPOSE: *Irrigation*
(home, irrigation, municipal, industrial)

WELL COMPLETION DATA:


- (1) diameter (inches) *12*
- (2) total depth (feet) *134*
- (3) static water level (feet) *22* below top of ground
- (4) casing *steel*, *106*
(material) (depth)
- (size) if telescope see back.
- (5) screen *28*, *106*
(length) (depth to top)
- 12*, *steel*
(size) (material)
- (6) pump *25*, *1650*
(HP) (yield gpm)
- Elec.*
(type power)
- (7) electric log (yes or no)
- (organization running log)
- (8) how well bottom plugged *concrete*

description of formations encountered

from to

<i>Fine Clay</i>	<i>0</i>	<i>18</i>
<i>Fine Gravel</i>	<i>18</i>	<i>25</i>
<i>Coarse "</i>	<i>25</i>	<i>33</i>
<i>Clay</i>	<i>23</i>	<i>35</i>
<i>good sand</i>	<i>35</i>	<i>125</i>
<i>sand & gravel</i>	<i>125</i>	<i>134</i>

CODED

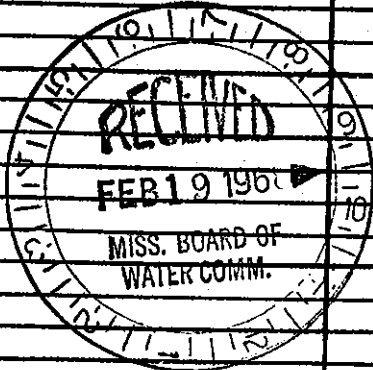

DRILLERS REMARKS: