

*Bolivar*  
*L 144*  
*2-68*

**CODED MISSISSIPPI BOARD OF WATER COMMISSIONERS**  
 416 North State Street  
 Jackson, Mississippi 39201

**CODED**

**WATER WELL DRILLERS LOG**

*2/3/68* 1968 *Delta Well Supply Co* *Bolivar*  
 date well completed firm name county well located

LANDOWNER:  
*E. D. Travis*  
*R. S. D. Boyle Miss.*  
 (mailing address)

description of formations encountered	from	to
<i>Top Clay</i>	<i>0</i>	<i>20</i>
<i>Fine Hard Sand</i>	<i>20</i>	<i>85</i>
<i>Sand &amp; gravel</i>	<i>85</i>	<i>129-8</i>

WELL LOCATION:  
 sec. *22 T 22 N R 14 W*  
*6* miles *South* of *Cleveland*  
 (distance) (direction) (nearest town)

**CODED**

WELL PURPOSE: *Irrigation*  
 (home, irrigation, municipal, industrial)

WELL COMPLETION DATA:

(1) diameter (inches) *16*

(2) total depth (feet) *129-8*

(3) static water level (feet) *23* below  
 top of ground.

(4) casing *Steel*, *89-8*  
 (material) (depth)  
 (size) If telescope see back.


(5) screen *40*, *89-8*  
 (length) (depth to top)  
*16*, *Steel*  
 (size) (material)

(6) pump *50*, *2400*  
 (HP) (yield gpm)  
*elec*  
 (type power)

(7) electric log (yes or no)

(organization running log)

(8) how well bottom plugged *Cement*

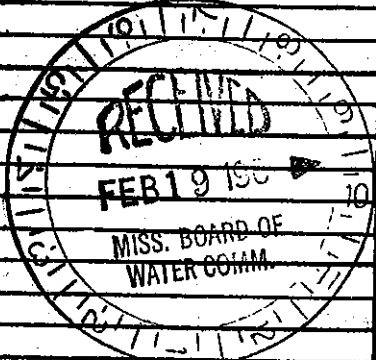

DRILLERS REMARKS: