

ED

CODED

BOLIVAR  
L 146  
2-68  
MS-GW 5876

MISSISSIPPI  
 BOARD OF WATER COMMISSIONERS  
 416 North State Street  
 Jackson, Mississippi 39201

WATER WELL DRILLERS LOG

2-26 1968 DYER WELL DR. BOLIVAR  
 date well completed firm name county well located

LANDOWNER: <u>J.H. HOWARTH JR.</u>	description of formations encountered	from	to
#1 <u>R.R. 2</u>			
<u>CLEVELAND, MISS</u> (mailing address)	<u>CLAY</u>	<u>0</u>	<u>15</u>
	<u>FINE BROWN SAND</u>	<u>15</u>	<u>34</u>
	<u>COARSE SAND</u>	<u>34</u>	<u>43</u>
	<u>COARSE SAND + GRAVEL</u>	<u>43</u>	<u>110</u>

WELL LOCATION:  
 sec. 20 T 22 N R. 6 W  
5 miles WEST of CLEVELAND  
 (distance) (direction) (nearest town)

WELL PURPOSE: IRRIGATION  
 (home, irrigation, municipal, industrial)

WELL COMPLETION DATA:

(1) diameter (inches) 16"

(2) total depth (feet) 107 FT

(3) static water level (feet) 19 below top of ground.

(4) casing IRON 67 FT  
 (material) (depth)

16"  
 (size) if telescope see back.

(5) screen 40 FT, 67 FT  
 (length) (depth to top)

16" BLIC IR.  
 (size) (material)


(6) pump 30 1800  
 (HP) (yield gpm)

ELEC.  
 (type power)

(7) electric log No  
 (yes or no)

(organization running log) PLATE

(8) how well bottom plugged \_\_\_\_\_

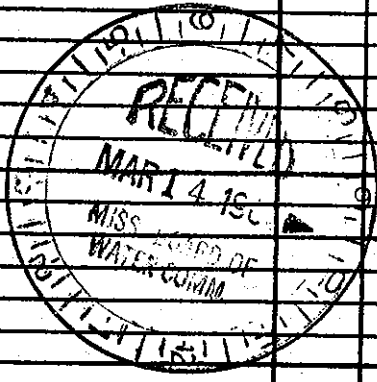

DRILLERS REMARKS: