

CODED

CODED

BOLIVER
L 147
3-68

MISSISSIPPI
BOARD OF WATER COMMISSIONERS
416 North State Street
Jackson, Mississippi 39201

WATER WELL DRILLERS LOG

3/86 1968 Delta Mills Supply Co Bolivar
date well completed firm name county well located

LANDOWNER:
J. C. Hardin
W. F. D. Cleveland
(mailing address)

description of formations encountered	from	to
Top Clay	0	20
Fine sand	20	55
Coarse sand	55	85
Small gravel	85	143

WELL LOCATION:
sec. 2 T. 22 N R. 6 E
5 miles 7 1/2 mi. Cleveland
(distance) (direction) (nearest town)

WELL PURPOSE: Irrigation
(home, irrigation, municipal, industrial)

WELL COMPLETION DATA:

(1) diameter (inches) 16

(2) total depth (feet) 143

(3) static water level (feet) 21 below above top of ground


(4) casing steel (material), (depth), (size) If telescope see back.

(5) screen 40 (length), (depth to top) 16 steel (size) (material)

(6) pump 7.5 3000 (HP) (yield gpm)
Diesel (type power)

(7) electric log (yes or no)
(organization running log)

(8) how well bottom plugged Cement

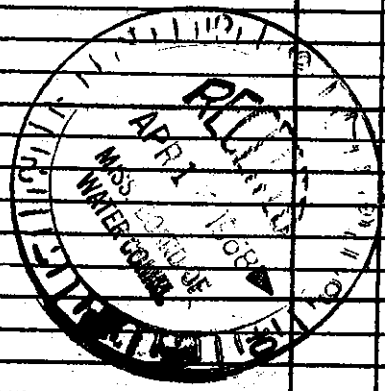

DRILLERS REMARKS: