

Bolivar
 148
 10-66

MISSISSIPPI BOARD OF WATER COMMISSIONERS

WATER WELL DRILLERS LOG

CODED

Date: 10-28, 19 66, Driller: Butane Gas Co., County Bolivar

(Name)

(1) Owner of Land: Joe Cole
 (Name)
Rt. 1, Boyle, Miss.
 (Address)

(2) Location: NE 1/4, NW 1/4, Sec. 13 T. 21 R. 6
3 miles W of Cleveland
 (distance) (direction) (Nearest Town)

(3) Topography: Flat
 (Hilly) (Flat) (Level)

(4) Purpose of Well: Domestic
 (Domestic Irrigation
 Municipal, Industrial, Other)

Description & Color of Materials Sand, Clay, Red Clay, Shell, etc.	Thick- ness Feet	Depth Feet
Clay	6	6
Sand	82	88
Sand & Gravel	124	212
Clay	82	294
Sand & Clay	43	337
Sand	261	598
Sand & Shale	80	678
Clay	80	758
Sand	7	765
Clay	22	787
Sand	19	806
Hard Packed Sand	34	840
Shale	8	848

Information upon completion of well:

(1) Diameter 4 3/4 inches.

(2) Total Depth 848 feet.

(3) Water Level _____ feet below top of ground.

(4) Cased to 839, Size 4" X 2"


(5) Screen: Size 2", Length 20 Ft.

(6) Were any formations sealed against pollution?
 _____ yes, no.

If YES depth of formation _____

Why _____

Drillers Remarks: _____

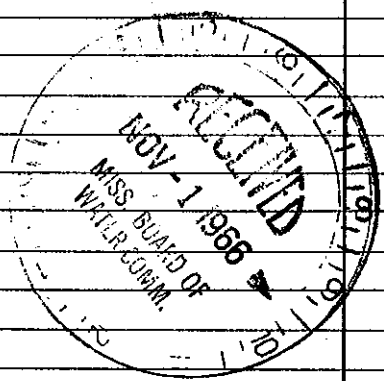

(Use Back Side)

Well No.

Mail this copy to Board of Water Commissioners 429 Miss. St. Jackson, Miss.