

BOLIVAR
L 193

MISSISSIPPI DEPARTMENT OF NATURAL RESOURCES
Bureau of Land and Water Resources
Southport Mall
P.O. Box 10631
Jackson, Mississippi 39209
WATER WELL DRILLERS LOG

CODED

6-85 19 Cook Drilling Co. Bolivar
date well completed firm name county well located

LANDOWNER:
Circle H Farms
Spine Miss.
(mailing address)

description of formations encountered	from	to
<u>Clay</u>	<u>Top</u>	<u>3.5'</u>
<u>Soft sand</u>	<u>3.5'</u>	<u>70'</u>
<u>Sand & gravel</u>	<u>70'</u>	<u>120'</u>


WELL LOCATION:
sec 28 T 22 N R 6 E
W
8 miles South of Pace
(distance) (direction) (nearest town)

WELL PURPOSE: Res
(home, irrigation, municipal, industrial)

WELL COMPLETION DATA:
(1) diameter (inches) 16"
(2) total depth (feet) 120
(3) static water level (feet) 28 below above top of ground.
(4) casing Steel, 80
(material) (depth)
16 if telescope see back.
(size)
(5) screen 40, 80'
(length) (depth to top)
16", Steel
(size) (material)
(6) pump 50, 2000
(HP) (yield gpm)
Diessl
(type power)
(7) electric log
(yes or no)

(organization running log)
(8) how well bottom plugged Plate

CODED

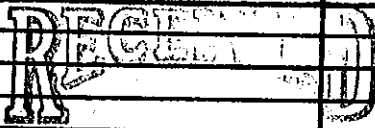

SEP 29 1986

DRILLERS REMARKS:

Department of Natural Resources
Bureau of Land & Water Resources