County: Bolivar	
Permit#:	t
Date drilling completed: 6-21-05	

State Well Report

Part 1

Mississippi Department of Environmental Quality Office of Land and Water Resources P.O. Box 10631 Jackson, MS 39289-0631 (601)961-5210 (601)354-6938 (fax)


	For Office Use Only:
Aquife	·
Well #:	1-224
L. S. E	levation:
E-log#	:

ared by the driller in detail and filed with the Department within

30 days of completion of drilling of the well.		
Well Owner Information	Well Location	
Owner NameJeffery Fioranelli	Latitude: 33 • 47 • 29 " Longitude: 90 • 50 • 29 "	
Mailing Address: 2991 Hwy. 8	Method of Lat/Long (circle one): Conventional Survey,	
	USGS quad, Hand-held GPS, Survey-grade GPS	
	NW 1/4 NE 1/4 Sec 5 Twn 22N Rng 6W	
Cleveland, MS 38732		
City State Zip Code	Distance Direction Nearest Town 1 Miles East of Pace	
Telephone No (662) 719 - 3450		
Well	Data	
Purpose of Well (circle one) Home Industrial Public Supply	trigation Fish Culture Other:	
Date well drilling started: $6-21-05$ Date	well drilling completed: 6-21-05	
If flowing, method of flow regulation: Valve Other (c		
Static Water Level:feet above or below (circle one)		
#		
Method of Measurement (circle one) steel tape electric tape		
Hole depth: 123 Well depth: 123	_ Well grouted to a depth of1 ()feet	
Type of grout (circle one): Cement Centonite Mix		
Casing length: 83 feet Casing diameter: 16	inches Type of casing: PVC Sch. 40	
Screen length: 40 feet Screen diameter: 16	inches Type of screen: PVC Sch. 40	
Screen slot size: . 050 inches Setting depth: From		
Type of completion (circle all applicable): Gravel packed Under		
Top of lap pipe or reduction in casing:feet. If t		
Logs run (circle all applicable): No log run Electric Gamma Ra	y Density Sonic Neutron Other:	
Name of organization running log(s):	14. Harrisalla minerate of the Ministerni	
I certify that the well was drilled, constructed, and completed in accordance with all applicable requirements of the Mississippi		
Department of Environmental Quality and/or the Mississippi De	epartment of freath regulations and state laws.	
Irrigation Equipment Inc. Patrick M. Chism 0695	tatus m Chris	
Print Name of Water Well Contractor and License No.	Signature of Water Well Contractor	

Owner contracted with Peacock Pump & Repair. Peacock Pump & Repair will install pump.

replacement well for Go 31689?

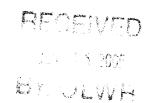


Ground Level

Description of Formations Encountered	From	To
Clay	0	25
Fine Sand	26	55
Med. Sand/gravel	56	85
Med. Sand/gravel Coarse Sand/gravel	86	123
	┦	4
	 	1
	-	1
		+-+
	+	1
	┿	1
		+
	 -	+
		┼
		┼
	┼─	+
	+-	
	- 	+
	 	+1
	+	1 -
	+	+-
	+	┼─┤
	+-	+-
	+-	+

If more than one screen, show location of each on sketch

Sketch the property layout and include the following: 1) the well location; 2) any permanent structures on the property that may aid in locating the well; 3) any roads, power lines, or other items that may aid in locating the property and the well; 4) indicate direction.

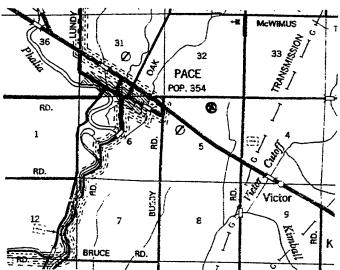

Landowner Name:	
Landownici Ivanic.	

Signature of Water Well Contractor

STATE WELL REPORT

County: Bolivar

Part 2 Pump Installer's Completion Report
Mississippi Department of Environmental Quality
Office of Land and Water Resources
P.O. Box 10631

For Office Use Only:		
Aquifer:		
Well #: L - 224		
Elevation:		

Driller: J Date completed:	Fackson, MS 39289-0631 Well #:
installation of pump.	er in detail and filed with the Department within 30 days of the
Well Owner Information	Well Location
Owner Name: Jeffery Fioranelli	Latitude: Longitude:
Mailing Address:	Method of Lat/Long (circle one): Conventional Survey,
2991 HWY 8 West	
Cleveland MS. 3873 City State Zip Code	2 NN 4 NE 4 Sec 5 Twn 22 N Rng 6 N
Oity State Zap Code	Distance Direction Nearest Town
Telephone No. (62) 7/9-3450	
Pump Type Circle one	Power Type Circle one
Air Lift Jet Submersible	Diesel Engine Gasoline Engine Natural Gas
Bucket Piston Turbine	Electric Motor Hand Tractor PTO
Centrifugal Rotary Flowing Well	
Other (specify):	Horse Power Rating of Motor:
Date Pump Installed: 6-22-05	Setting Depth: 70 feet
Rated Pump Capacity:Gallons Per Min	nute Number of Stages:
Pump Test Data	Method of Measuring Water Level Circle one
Date Well Tested:	
Static Water Level (A): Feet Below Land Su	Air Line Electric Measuring Line Steel Tape
Pumping Water Level (B):Feet Below Land Sur	Other (specify):
Drawdown [(B) - (A)]:Feet Below Land Sur	rface For flowing well, measured shut in head:feet
Test Pumping Rate:Gallons Per Mi	nute Well yieldedGPM with a drawdown of
Duration of Pump Test (minimum 4 hours):he	oursfeet afterhours of pumping
I HEREBY CERTIFY that the above statements are true to	the best of my knowledge.

I HEREBY CERTIFY that the above statements are true to the best of my kn	owledge.
Pacack's Pump + Repair Inc 0728P	Jonny Leasach M.
Print Name of Pump Installer and License No. (if applicable)	Signature of Pump Installer

3. 15 300