

#2

County: Bolivar
 Permit #: 6W42988
 Driller: Clarence McMurcy
 Date drilling completed: 1-22-09

State Well Report
Part 1 - Driller's Log
 Mississippi Department of Environmental Quality
 Office of Land and Water Resources
 P.O. Box 2307
 Jackson, MS 39225
 (601)961-5210
 (601)961-5220 (fax)

For Office Use Only:
 Aquifer: _____
 Well #: L-296
 L.S. Elevation: _____
 E-log #: _____

State Law requires that this report be prepared by the license holder responsible for the work and filed with the Department at the above address within 30 days of completion of drilling of the well or borehole.

Information on Well Owner (Landowner if borehole is not for a water well)	Well or Borehole Location
Owner Name: <u>Fioravelli Farms</u>	Latitude: <u>N 33° 46' 06" Longitude: <u>W 90° 47' 63.0"</u></u>
Mailing Address: <u>P.O. Box 1596</u>	Method of Lat/Long (circle one): <u>Conventional Survey</u>
<u>Cleveland MS 38732</u>	USGS quad, Hand-held GPS, Survey-grade GPS
City State Zip Code	<u>N 1/4 SW 1/4 Sec 11 Twn 22 Rng 6W</u>
Telephone No. <u>(662) 515-8340</u>	Distance Direction Nearest Town
	<u>2.5 Miles NW of Cleveland</u>

Well / Borehole Data

Date drilling started: 1-22-09 Date drilling completed: 1-22-09 Hole depth: 120' Hole diameter: 2 1/2"

Location of the source of any surface water used for drilling: existing well
 Method of dosing and volume of Chlorine used in drilling and development: _____

Logs run (circle all applicable): NO log run Electric Gamma Ray Density Sonic Neutron Other: _____
 Name of organization running log(s): _____

Purpose of borehole (check one): Water Well Geotechnical/Geological Investigation _____ Ground Source Heat Pump _____
 Seismic Survey _____ Other (describe) _____
If drilling is not related to water well construction, skip the remainder of this block

Purpose of Well (check one): Home _____ Industrial _____ Public Supply _____ Irrigation _____ Fish Culture _____ Other: _____

If a flowing well, method of flow regulation: Valve _____ Other (describe) _____

Static Water Level: 38 feet above or below (circle one) land surface Date measured: 1-23-09

Method of Measurement (circle one) steel tape electric tape air line other: _____

Well depth: 120' Well grouted to a depth of 10 feet Type of grout (circle one): Neat Cement Bentonite Mix

Casing length: 60 feet Casing diameter: 16 inches Type of casing: PVC

Screen length: 60 feet Screen diameter: 16 inches Type of screen: PVC

Screen slot size: .050 inches Setting depth: From 60 feet to 120 feet

Type of completion (circle all applicable): Gravel packed Underreamed Telescoped Open hole Natural Development
 Other (describe): _____

Top of top pipe or reduction in casing: N/A feet *If telescoped or more than one screen, describe on next page*

Form: OLWR-SWR-1A (04/08)

RECEIVED

JAN 28 2009

BY: OLWR


L-246

The sketch below only required for water wells

If well telescopes, show depths on sketch

Ground Level →

GW42988

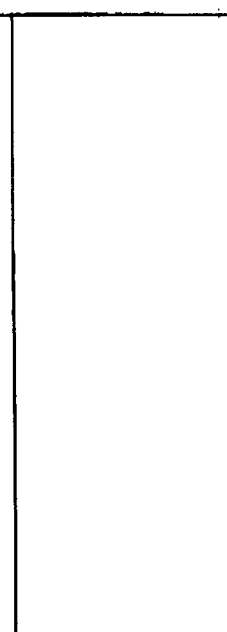


Description of formations encountered must be provided for all wells and boreholes, unless specifically exempted by regulations

Description of Formations Encountered	From (depth)	To (depth)
Clay	Ground Level	36
Coarse Sand	36	71
Medium Sand	71	79
Coarse Sand & Gravel	79	97
Medium Sand	97	101
Coarse Sand & Gravel	101	118
Coarse Sand	118	120

If more than one screen, show location of each on sketch

Sketch the property layout and include the following: 1) the well location; 2) any permanent structures on the property that may aid in locating the well; 3) any roads, power lines, or other items that may aid in locating the property and the well; 4) a north arrow.

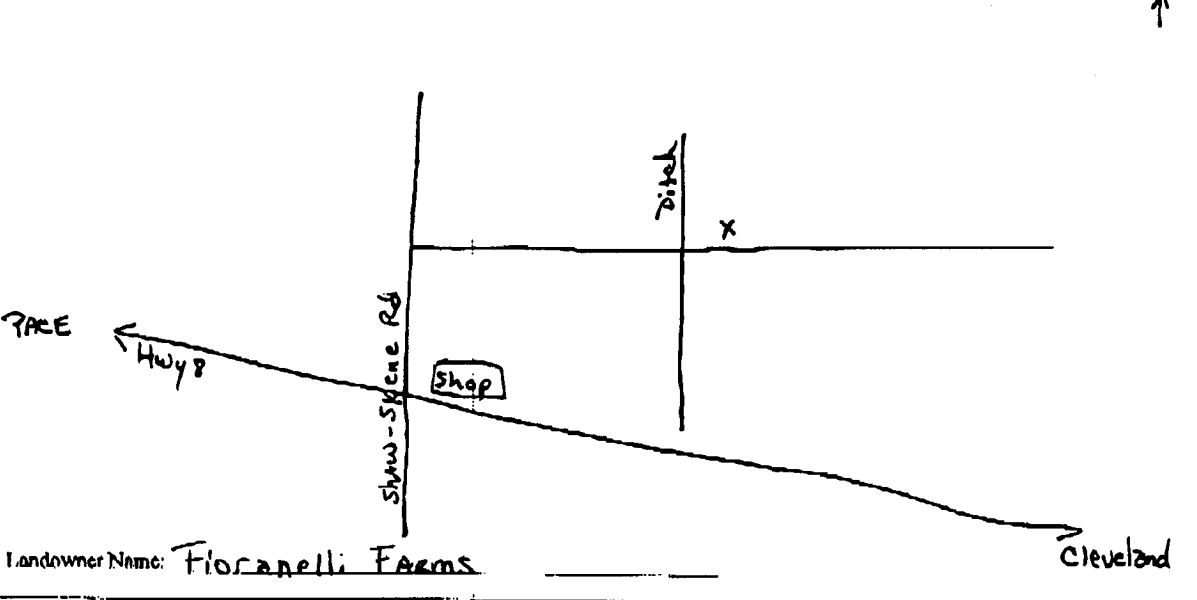

Form: OLWR-SWR-1A (04/08)

I certify that the well/borehole was drilled, constructed, and completed in accordance with all applicable requirements of the Mississippi Department of Environmental Quality and the Mississippi Department of Health regulations, if applicable, and state laws.

Print Name of Responsible Licensee and License No. Clayton Miller

Date 1-28-09

Signature of Licensee Clayton Miller

RECEIVED
JAN 28 2009
BY: OLWR

H2

STATE WELL REPORT

Part 2

Pump Installer's Completion Report
 Mississippi Department of Environmental Quality
 Office of Land and Water Resources
 P.O. Box 2309
 Jackson, MS 39225
 (601)961-5210
 (601)961-5228 (fax)

County Bolivar
 Permit # 6W4298B
 Driller John Rybolt IV
 Date completed 1-23-09
 Copy information from block on Part 1

For Office Use Only:
 Aquifer _____
 Well # L-246
 Elevation _____

This part of the report must be completed by a licensed water well contractor or a licensed pump installer. A copy of Part 1 of the report must be attached and both parts filed with the Department at the above address within 30 days of well completion.

Well Owner Information	Well Location
Owner Name: <u>Fioravelli Farms</u>	Latitude: <u>N33° 46' 09.6"</u> Longitude: <u>W90° 47' 62.0"</u>
Mailing Address: <u>P.O. Box 1596</u>	Method of Lat/Long (check one): Conventional Survey <input type="checkbox"/>
<u>Cleveland MS 38732</u>	USGS quad _____ Hand-held GPS <input type="checkbox"/> Survey-grade GPS <input type="checkbox"/>
City State Zip Code	1/4 _____ 1/4 Sec _____ T _____ R _____
Telephone No. <u>(662) 515-8340</u>	Distance Direction Nearest Town
	<u>2.5 Miles NW of Cleveland</u>

Pump Type Circle one	Power Type Circle one
Air Lift <input type="checkbox"/> Jet <input type="checkbox"/> Submersible <input type="checkbox"/>	Diesel Engine <input type="checkbox"/> Gasoline Engine <input type="checkbox"/> Natural Gas <input type="checkbox"/>
Rocket <input type="checkbox"/> Piston <input type="checkbox"/> <u>Turbine</u> <input checked="" type="checkbox"/>	Electric Motor <input type="checkbox"/> Hand <input type="checkbox"/> Tractor PTO <input type="checkbox"/>
Centrifugal <input type="checkbox"/> Rotary <input type="checkbox"/> Flowing Well <input type="checkbox"/>	Windmill <input type="checkbox"/> Other (specify): <u>Gear Drive</u>
Other (specify): _____	Horse Power Rating of Motor: <u>60 hp</u>
Date Pump Installed: <u>1-23-09</u>	Setting Depth: <u>70</u> feet
Rated Pump Capacity: _____ Gallons Per Minute	Number of Stages: <u>1</u>

Pump Test Data	Method of Measuring Water Level Circle one
Date Well Tested: <u>NOT TESTED</u>	Air Line <input type="checkbox"/> <u>Electric Measuring Line</u> <input checked="" type="checkbox"/> Steel Tape <input type="checkbox"/>
Static Water Level (A): <u>38</u> Feet Below Land Surface	Other (specify): _____
Pumping Water Level (B): <u>N/A</u> Feet Below Land Surface	For flowing well, measured shut in head: <u>N/A</u> feet
Drawdown [(B) - (A)]: <u>N/A</u> Feet Below Land Surface	Well yielded _____ GPM with a drawdown of _____ feet after _____ hours of pumping
Test Pumping Rate: <u>N/A</u> Gallons Per Minute	
Duration of Pump Test (minimum 4 hours): <u>N/A</u> hours	

I HEREBY CERTIFY that the above statements are true to the best of my knowledge

Clayton Miller 0-703 Clayton Miller
 Print Name of Pump Installer and License No. (if applicable) Signature of Pump Installer

Form: OLWR-SWR-1B (04/08)

RECEIVED

JAN 28 2009

BY: OLWR

#2

County Bolivar
 Permit #: OW 42988
 Driller: Clarence M. Muccy
 Date drilling completed: 1-22-09

State Well Report
Part 1 - Driller's Log
 Mississippi Department of Environmental Quality
 Office of Land and Water Resources
 P.O. Box 2307
 Jackson, MS 39225
 (801)981-5210
 (801)961-5228 (fax)

For Office Use Only:
 Aquifer: _____
 Well #: L-246
 L.S. Elevation: _____
 E-log #: _____

State Law requires that this report be prepared by the license holder responsible for the work and filed with the Department at the above address within 30 days of completion of drilling of the well or borehole.

Information on Well Owner (Landowner if borehole is not for a water well)	Well or Borehole Location
Owner Name: <u>Lionelli Farms</u>	Latitude: <u>N 33° 46' 09"</u> Longitude: <u>W 90° 47' 42"</u>
Mailing Address: <u>P.O. Box 1596</u>	Method of Lat/Long (circle one): <u>Conventional Survey</u> , USGS quad, Hand-held GPS, Survey-grade GPS
<u>Cleveland MS 38732</u> City State Zip Code	USGS quad: <u>NW 1/4 SW 1/4 Sec 11 Twn 22N Rng 6W</u>
Telephone No. <u>(662) 515-8340</u>	Distance: <u>2.5</u> Miles Direction: <u>NW</u> of Nearest Town: <u>Cleveland</u>

Well / Borehole Data

Date drilling started: 1-22-09 Date drilling completed: 1-22-09 Hole depth: 120' Hole diameter: 24"

Location of the source of any surface water used for drilling: existing well
 Method of dosing and volume of Chlorine used in drilling and development: _____

Logs run (circle all applicable): No log run Electric Gamma Ray Density Sonic Neutron Other: _____
 Name of organization running log(s): _____

Purpose of borehole (check one): Water Well Geotechnical/Geological Investigation _____ Ground Source Heat Pump _____
 Seismic Survey _____ Other (describe) _____
If drilling is not related to water well construction, skip the remainder of this block.

Purpose of Well (check one): Home _____ Industrial _____ Public Supply _____ Irrigation Fish Culture _____ Other _____

If a flowing well, method of flow regulation: Valve _____ Other (describe) _____

Static Water Level: 38 feet above or below (circle one) land surface Date measured: 1-23-09

Method of Measurement (circle one) steel tape electric tape air line other: _____

Well depth: 120' Well grouted to a depth of 10 feet Type of grout (circle one): Neat Cement Bentonite Mix

Casing length: 60 feet Casing diameter: 16 inches Type of casing: PVC

Screen length: 60 feet Screen diameter: 16 inches Type of screen: PVC

Screen slot size: .050 inches Setting depth: From 60 feet to 120 feet

Type of completion (circle all applicable): Gravel packed Underreamed Telescoped Open hole Natural Development
 Other (describe): _____

Top of lap pipe or reduction in casing: N/A feet *If telescoped or more than one screen, describe on next page*

Form: OLWR-SWR-1A (04/08)

RECEIVED

FEB 3 2009

YMD JOINT WATER MANAGEMENT DISTRICT

42988