


BOLIVAR MISSISSIPPI BOARD OF WATER COMMISSIONERS

M 50
 8-26-64

WATER WELL DRILLERS LOG 10/17/64

Date: August 26, 1964, Driller: Layne-Central Company County Bolivar M50
 (Name)

(1) Owner of Land: City of Cleveland (Name)	Description & Color of Materials Sand, Clay, Red Clay, Shell, etc.	Thick- ness Feet	Depth Feet
Cleveland, Mississippi (Address)	Clay	15	15
(2) Location: $\frac{1}{4}$, $\frac{1}{4}$, Sec. 20 T22N R5W	Sandy clay	20	5
_____ miles _____ of Cleveland , (distance) (direction) (Nearest Town)	Brown sand	19	39
(3) Topography: flat (Hilly) (Flat) (Level)	Coarse sand	14	53
(4) Purpose of Well: domestic (Domestic Irrigation, Municipal, Industrial, Other)	Coarse sand & pea gravel	88	141
Information upon completion of well:	Clay	16	157
(1) Diameter 18x12 inches.	Shale with sandy shale strks.	21	178
(2) Total Depth 794 feet.	Fine sand	10	188
(3) Water Level 31 feet below top of ground.	Fine sand & clay strks.	5	193
(4) Cased to 700' , Size 12" Blank	Sand	18	211
(5) Screen: Size 12" , Length 80'	Clay	2	213
(6) Were any formations sealed against pollution?	Sand	13	226
_____ yes, _____ no.	Sand & small clay strks.	115	341
If YES depth of formation 700' cemented, B.P.V. Gravel wall well with 67' Why of lap.	Clay	13	354
Drillers Remarks:	Sand & clay strks.	75	429
	Clay & sand strks.	26	455
	Clay	9	464
	Sand & clay	18	482
	Clay	14	496
	Sand & clay	12	508
	Clay & small sand strks.	27	535
	Clay	99	634
	Sandy shale & clay	26	660
	Fine sand & clay strks.	10	670
	Sand	124	794
	Clay	20	814

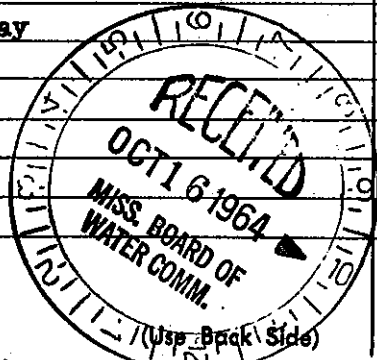

Well No.

Mail this copy to Board of Water Commissioners 429 Miss. St. Jackson, Miss