

BOLIVAR

MISSISSIPPI BOARD OF WATER COMMISSIONERS

M-72

6-1-57

WATER WELL DRILLERS LOG

10/25/65

439
CODED

Date: June 1, 1957, Driller: Layne-Central Company
(Name)

(1) Owner of land: Barbour Brothers (Name)	Description & Color of Materials Sand, Clay, Red Clay, Shell, etc.	Thick- ness Feet	Depth Feet
Cleveland, Mississippi (Address)	Clay	8	8
(2) Location: 1/4, 1/4, Sec. 8 T22R5	Sandy clay	16	24
5 miles west of Merigold (distance) (direction) (Nearest Town)	Fine sand	12	36
(3) Topography: flat (Hilly) (Flat) (Level)	Medium sand	16	52
(4) Purpose of Well: irrigation (Domestic Irrigation, Municipal, Industrial, Other)	Coarse sand	26	78
	Coarse sand, gravel	34	112

CODED

Information upon completion of well:


- (1) Diameter 18x12 inches.
- (2) Total Depth 112 feet.
- (3) Water Level 17' 5" feet below top of ground.
- (4) Cased to 55' of 18" x 12" Swage Size 18"
- (5) Screen: Size 12", Length 50' of 12"
- (6) Were any formations sealed against pollution?
yes, no no.

If YES depth of formation

Why

Drillers Remarks:

2400 GPM.

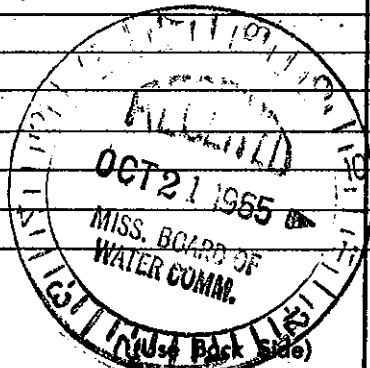

Well No.