

Bolivar MISSISSIPPI BOARD OF WATER COMMISSIONERS

M-74

WATER WELL DRILLERS LOG

2-66

Date: 4/20, 1966, Driller: Dutton Well Supply **CODED**

(Name)

(1) Owner of Land:	Description & Color of Materials Sand, Clay, Red Clay, Shell, etc.	Thick- ness Feet	Depth Feet
<u>E. P. M. Smith</u> (Name) <u>Chleveland</u> (Address)	<u>Top soil clay</u>	<u>29</u>	
(2) Location: <u>1/4</u> , <u>1/4</u> , Sec. <u>9</u> , <u>T22R5</u> , <u>3</u> miles <u>North</u> , of <u>Pace</u> (distance) (direction) (Nearest Town)	<u>Fine sand blue</u> <u>with clay breaks</u>	<u>30</u>	<u>59</u>
(3) Topography: <input checked="" type="checkbox"/> (Hilly) <input type="checkbox"/> (Flat) <input type="checkbox"/> (Level)	<u>Sand & gravel</u>	<u>60</u>	<u>119</u>
(4) Purpose of Well: <u>Irrigation</u> (Domestic Irrigation Municipal, Industrial, Other)	<u>2 wells</u> CODED		

Information upon completion of well:

(1) Diameter 12 inches.

(2) Total Depth 119 feet.

(3) Water Level 19 feet below top of ground.

(4) Cased to 81, Size 12


(5) Screen: Size 20, Length 38

(6) Were any formations sealed against pollution?
 yes, no.

If YES depth of formation _____

Why _____

Drillers Remarks: _____

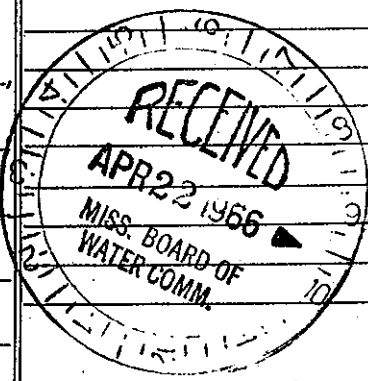

Well No. _____

(Use Back Side)

Mail this copy to Board of Water Commissioners 429 Miss. St. Jackson, Mis: