

BOLIVAR

M-80

7-8-58

MISSISSIPPI BOARD OF WATER COMMISSIONERS

WATER WELL DRILLERS LOG


11/1/65
CODED
jm

Date: July 8, 1958, Driller: Layne-Central Company County Bolivar

(Name)

	Description & Color of Materials Sand, Clay, Red Clay, Shell, etc.	Thick- ness Feet	Depth Feet
(1) Owner of Land: W. L. Smith (Name) Cleveland, Mississippi (Address)	Sandy clay	31	31
	Sand	71	102
	Sand & gravel	66	168
(2) Location: <u>1/4</u> , <u>1/4</u> , Sec. <u>12</u> T. <u>22N</u> S. <u>5W</u> <u>5</u> miles northeast , of Cleveland (distance) (direction) (Nearest Town)	Fine sand, strks. clay	56	224
	H. Packed sand, strks. lignite	66	290
(3) Topography: flat (Hilly) (Flat) (Level)	H. Packed sand	32	322
	Clay	4	326
(4) Purpose of Well: domestic (Domestic Irrigation Municipal, Industrial, Other)	Fine H. Packed sand	32	358
	Clay	5	363
	Sand strks. lignite	65	428
Information upon completion of well:	Hard shale	44	472
(1) Diameter 8x4 inches.	Real fine sand	43	515
(2) Total Depth 712' - 2" feet.	H. Packed sand, strks. clay & lignite	106	621
(3) Water Level 20' feet below top of ground.	Soap stone	8	629
(4) Cased to 518' , Size 8" swage .	H. Packed sand	83	712
(5) Screen: Size 4" , Length 30' 2" , 10' 3" shot at bottom .	Bottom		
(6) Were any formations sealed against pollution? yes yes, no no.			
If YES depth of formation Cement plug and 200 lbs. at bottom.			
Why			
Drillers Remarks: 30 GPM.			
Electric power.			

CODED

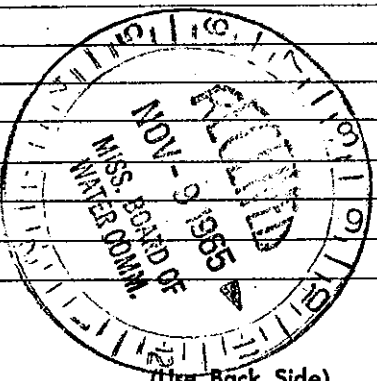

(Use Back Side)

Well No.