

**BOLIVAR MISSISSIPPI BOARD OF WATER COMMISSIONERS**

**M-82**

**11-15-62**

**WATER WELL DRILLERS LOG**

Date: 11-15, 1962, Driller: ONTANE GAS CO

(Name)

**CODED**

*Bolivar*

*LESTER*

	Description & Color of Materials Sand, Clay, Red Clay, Shell, etc.	Thick- ness Feet	Depth Feet
(1) Owner of Land: <u>A. V. Reecon</u> (Name) <u>BOYLE MISS</u> (Address)	CLAY	16	16
	SAND & GRAVEL	104	180
	SAND WHITE	30	510
(2) Location: <u>1/4</u> , <u>1/4</u> , Sec. <u>31</u> <u>T22R5</u>	CLAY (BLUE)	20	530
<u>1 1/2</u> miles <u>WEST</u> of <u>BOYLE</u> (distance) (direction) (Nearest Town)	SAND & CLAY STRIPES	23	553
	CLAY (BLUE)	42	595
(3) Topography: <u>FLAT</u> (Hilly) (Flat) (Level)	SAND ( <del>COARSE</del> )	21	616
	SAND (BAD FINE)	21	637
(4) Purpose of Well: <u>DOMESTIC</u> (Domestic Irrigation Municipal, Industrial, Other)	SAND (COARSE)	43	680

Information upon completion of well:


- (1) Diameter 4" x 2" inches.
- (2) Total Depth 680 feet.
- (3) Water Level 15 feet below top of ground.
- (4) Cased to 660', Size 4" x 2"
- (5) Screen: Size 2", Length 20'
- (6) Were any formations sealed against pollution?  
 yes,  no.

If YES depth of formation \_\_\_\_\_

Why \_\_\_\_\_

Drillers Remarks: \_\_\_\_\_

**CODED**

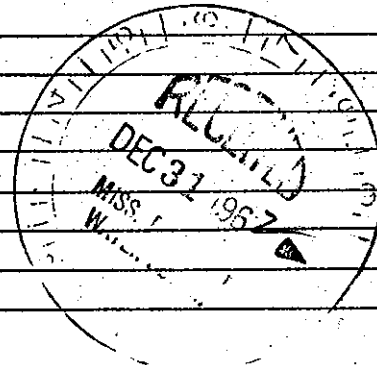

(Use Back Side)

Well No.

Mail this copy to Board of Water Commissioners 429 Miss. St. Jackson, Miss.