

BOLIVAR
M-83
7-1-65

MISSISSIPPI BOARD OF WATER COMMISSIONERS

MSGW06202

WATER WELL DRILLERS LOG


CODED

Date: 7/1, 1965, Driller: Debra Wells Supply County Bolivar
 (Name)

(1) Owner of Land:	Description & Color of Materials Sand, Clay, Red Clay, Shell, etc.	Thick- ness Feet	Depth Feet
(Name) <u>W. L. S. McCoal</u> <u>RFD Cleveland</u> (Address) <u>2 216</u>	<u>Sandy top soil</u> <u>Thin layers</u>	<u>19</u>	
(2) Location: <u>1/4</u> , <u>1/4</u> , Sec. <u>7</u> T <u>22R</u> S. <u>3</u> miles <u>No. West</u> of <u>Cleveland</u> (distance) (direction) (Nearest Town)	<u>Clay breaks</u> <u>Well sand</u> <u>Course</u>	<u>30</u> <u>11</u> <u>38</u>	<u>49</u> <u>60</u> <u>98</u>
(3) Topography: <input checked="" type="checkbox"/> (Hilly) <input type="checkbox"/> (Flat) <input type="checkbox"/> (Level)			
(4) Purpose of Well: <u>Irrigation</u> (Domestic, Irrigation, Municipal, Industrial, Other)			
Information upon completion of well:			
(1) Diameter <u>8</u> inches.			
(2) Total Depth <u>98</u> feet.			
(3) Water Level <u>21</u> feet below top of ground.			
(4) Cased to _____, Size _____.			
(5) Screen: Size <u>8"</u> , Length <u>24ft</u> .			
(6) Were any formations sealed against pollution? _____ yes, _____ no.			
If YES depth of formation _____.			
Why _____.			
Drillers Remarks: _____.			
Yield in G. P. M.: <u>600</u>			
Type power: <u>Tractor</u>			
Crops irrigated & Acreage: <u>Cotton & Beans</u>			

CODED

CODED

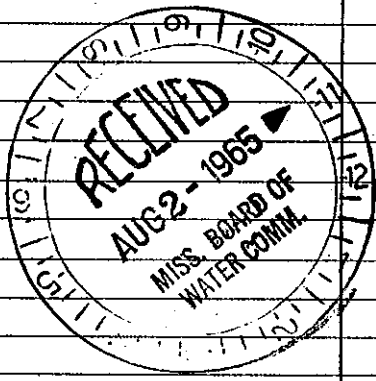

Well No.

(Use Back Side)

Mail this copy to Board of Water Commissioners 429 Miss. St. Jackson, Miss.