

BOLIVAR
M-85 MISSISSIPPI BOARD OF WATER COMMISSIONERS

7-28-65 WATER WELL DRILLERS LOG

Date: 7/28, 1965, Driller: Delta Well Supply Co County Bolivar
Pleasant Liv (Name)

(1) Owner of Land: E. S. Pleasant
 (Name)
Cleveland
 (Address)

(2) Location: 1/4, 1/4, Sec. 7 22R50E
3 miles W. West, of Cleveland
 (distance) (direction) (Nearest Town)

(3) Topography: (Hilly) (Flat) (Level)

(4) Purpose of Well: Domestic
 (Domestic Irrigation
 Municipal, Industrial, Other)

Description & Color of Materials Sand, Clay, Red Clay, Shell, etc.	Thick- ness Feet	Depth Feet
CODED clay	18	
sand	27	45
sand + gravel	99	142
clay	30	172
sand fine	23	195
clay	85	280
sand med	90	370
clay	20	390
sand med	75	465
clay + shale	120	585
rock	1	646
shale	74	720
sand fine	75	795
" bourse	35	830

Information upon completion of well:

(1) Diameter 4x2 1/2 inches.

(2) Total Depth 828 feet.

(3) Water Level 22 feet below top of ground.

(4) Cased to _____, Size _____.

(5) Screen: Size 2 1/2, Length 20 ft.

(6) Were any formations sealed against pollution?
 _____ yes, _____ no.

If YES depth of formation _____


Why _____

Drillers Remarks: _____

Yield in G. P. M.: 30

Type power: 3HP Elec.

Crops irrigated & Acreage: _____

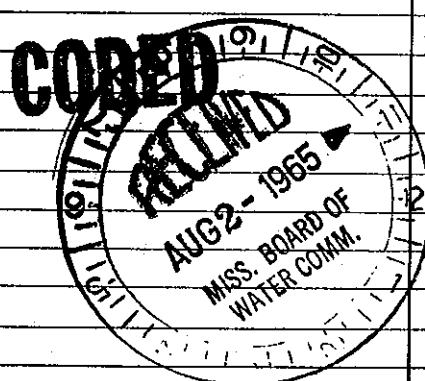

Well No.

(Use Back Side)

Mail this copy to Board of Water Commissioners 429 Miss. St. Jackson, Miss.