

BOLIVAR
M-86

MISSISSIPPI BOARD OF WATER COMMISSIONERS

11-30-65 WATER WELL DRILLERS LOG

Date: 11/30, 1965, Driller: Delta Wells Supply county Bolivar
(Name)


(1) Owner of Land: W.H. Friedrich
(Name)
Cleveland
(Address)
(2) Location: 1/4, 1/4, Sec. 18 T22R5,
1/2 miles West of Cleveland
(distance) (direction) (Nearest Town)
(3) Topography: (Level)
(4) Purpose of Well: Domestic
(Domestic Irrigation, Municipal, Industrial, Other)

Description & Color of Materials Sand, Clay, Red Clay, Shell, etc.	Thick- ness Feet	Depth Feet
CODED	24	
CODED	30	54
CODED	176	130
Rock	1	131
sand	14	145
Rock	1	146
Clay	114	260
m. sand	25	285
clay	20	305
sand	45	350
Clay	120	470
F. sand	10	530
shale	8	538
Clay & shale	172	710
sand & shale	90	800

Information upon completion of well:

(1) Diameter 4 1/2 inches.
(2) Total Depth 778 feet.
(3) Water Level 21 feet below top of ground.
(4) Cased to _____, Size _____
(5) Screen: Size 2, Length 20 ft.
(6) Were any formations sealed against pollution?
_____ yes, _____ no.

CODED

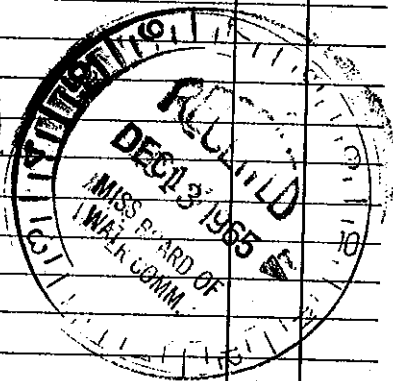

If YES depth of formation _____
Why _____
Drillers Remarks: _____
Field in G. P. M.: _____
Type power: _____
Irrigated & Acreage: _____

Well No.

(Use Back Side)

Mail this copy to Board of Water Commissioners 429 Miss. St. Jackson, Miss.