

BOLIVAR
M-87 MISSISSIPPI BOARD OF WATER COMMISSIONERS

2-4-66 WATER WELL DRILLERS LOG

CODED

Date: 2-4, 1966, Driller: BUTANE GAS CO OF GREENWICH County BOLIVAR
(Name)

(1) Owner of Land: J. E. KENDRICK
(Name)
CLEVELAND, Miss.
(Address)

(2) Location: 1/4, 1/4, Sec. 26 T22R5,
4 miles SO. EAST of CLEVELAND,
(distance) (direction) (Nearest Town)

(3) Topography: FLAT
(Hilly) (Flat) (Level)

(4) Purpose of Well: DOMESTIC
(Domestic irrigation
Municipal, Industrial, Other)

Description & Color of Materials Sand, Clay, Red Clay, Shell, etc.	Thick- ness Feet	Depth Feet
0-18 Gumbo	18	18
65 SAND	47	65
120 SAND & GRAVEL		120
168 CLAY	48	168
187 SHALE (SANDY)	19	187
620 SAND & SHALE	473	620
705 Gummy SHALE	85	705
765 HARD SAND	60	765
784 SANDY SHALE	19	784

Information upon completion of well:

(1) Diameter 4x2 inches.

(2) Total Depth 755 feet.

(3) Water Level 33' 4" **CODED**
ground. 126'

(4) Cased to 609', Size 2"

(5) Screen: Size 2", Length 20 FT.

(6) Were any formations sealed against pollution?
X yes, no.

If YES depth of formation _____


Why _____

Drillers Remarks: _____

Yield in G. P. M.: 18

Type power: ELECTRIC

Crops irrigated & Acreage: NONE

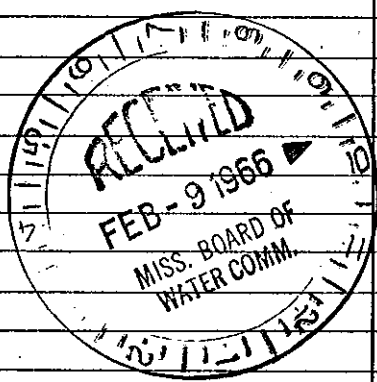

Well No.

(Use Back Side)

Mail this copy to Board of Water Commissioners 429 Miss. St. Jackson. Miss