

BOLIVAR

M 88

MISSISSIPPI BOARD OF WATER COMMISSIONERS

8-22-56

WATER WELL DRILLERS LOG

4/15/65
C 266

Date: Aug. 22, 1956, Driller: Layne-Central Company

CODED

(Name)

(1) Owner of Land: T. M. Jones
(Name)
Boyle, Mississippi
(Address)

(2) Location: 1/4, 1/4, Sec. 28 T22R5
1/2 miles southwest, of Boyle
(distance) (direction) (Nearest Town)

(3) Topography: flat
(Hilly) (Flat) (Level)

(4) Purpose of Well: irrigation
(Domestic Irrigation, Municipal, Industrial, Other)

Description & Color of Materials Sand, Clay, Red Clay, Shell, etc.	Thick- ness Feet	Depth Feet
Fine sand	16	16
Brown clay	9	25
Brown sand	5	30
Blue clay	2	32
Fine sand	8	40
Blue clay	8	48
Fine sand	8	56
Blue clay	11	67
Coarse sand	10	77
Coarse sand, pea gravel	45	122

Information upon completion of well:

(1) Diameter 16x12 inches.

(2) Total Depth 122 feet.

(3) Water Level 18'-8" feet below top of ground.

(4) Cased to 69'9", Size 16"
2' swage

(5) Screen: Size 12", Length 50'

(6) Were any formations sealed against pollution?
no yes, no no.

CODED

If YES depth of formation _____


Why _____

Drillers Remarks: _____

2000 GPM

electric motor

tain this copy for your office files.

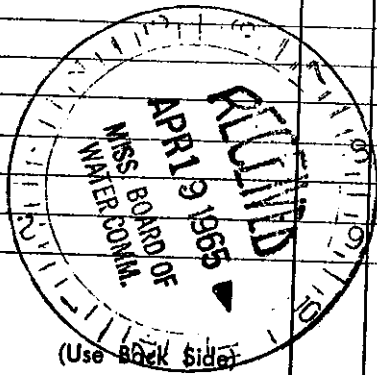

Well No. _____